

State Well Report

Part 1 - Driller's Log

Mississippi Department of Environmental Quality
Office of Land and Water Resources
P.O. Box 10631
Jackson, MS 39289-0631
(601)961-5210
(601)354-6938 (fax)

County: QUITMAN
Permit #: 6640505
Driller: HOUSTON
Date drilling completed: _____

For Office Use Only:

Aquifer: _____
Well #: K-24
L. S. Elevation: _____
E-log #: _____

State Law requires that this report be prepared by the license holder responsible for the work and filed with the Department at the above address within 30 days of completion of drilling of the well or borehole.

Information on Well Owner (Landowner if borehole is not for a water well)	Well or Borehole Location
Owner Name: <u>MICHEL WATTS</u>	Latitude: <u>34° 09' 58"</u> Longitude: <u>90° 20' 58"</u>
Mailing Address: <u>56 JOHN ST</u>	Method of Lat/Long (circle one): Conventional Survey, USGS quad, Hand-held GPS, Survey-grade GPS
<u>CLAUSSDALE MS 38614</u> City State Zip Code	<u>NE 1/4 NE 1/4 Sec 1 Twn 26N Rng 2W</u>
Telephone No. <u>(601) 624 6017</u>	Distance Direction Nearest Town _____ Miles _____ of _____
Well / Borehole Data	
Date drilling started: <u>6/20</u> Date drilling completed: <u>6/20</u> Hole depth: <u>110</u> Hole diameter: <u>18</u>	
Location of the source of any surface water used for drilling: <u>WELL</u>	
Method of dosing and volume of Chlorine used in drilling and development: <u>1LB PER 1000</u>	
Logs run (circle all applicable): <u>No log run</u> Electric Gamma Ray Density Sonic Neutron Other: _____	
Name of organization running log(s): _____	
Purpose of borehole (check one): Water Well <input checked="" type="checkbox"/> Geotechnical/Geological Investigation _____ Ground Source Heat Pump _____	
Seismic Survey _____ Other (describe) _____	
<i>If drilling is not related to water well construction, skip the remainder of this block</i>	
Purpose of Well (check one): Home _____ Industrial _____ Public Supply _____ Irrigation <input checked="" type="checkbox"/> Fish Culture _____ Other: _____	
If a flowing well, method of flow regulation: Valve _____ Other (describe) _____	
Static Water Level: <u>19</u> feet above or below (circle one) land surface Date measured: <u>6/21</u>	
Method of Measurement (circle one) <u>steel tape</u> electric tape air line other: _____	
Well depth: <u>110</u> Well grouted to a depth of <u>10</u> feet Type of grout (circle one): Neat Cement <u>Bentonite</u> Mix	
Casing length: <u>70</u> feet Casing diameter: <u>10</u> inches Type of casing: <u>PVC</u>	
Screen length: <u>40</u> feet Screen diameter: <u>10</u> inches Type of screen: <u>PVC</u>	
Screen slot size: <u>030</u> inches Setting depth: From <u>70</u> feet to <u>110</u> feet	
Type of completion (circle all applicable): <u>Gravel packed</u> Underreamed Telescoped Open hole Natural Development	
Other (describe): _____	
Top of lap pipe or reduction in casing: _____ feet. <i>If telescoped or more than one screen, describe on next page</i>	

RECEIVED

SEP 12 2005

BY: OLWR

RECEIVED

JUL 28 2005

BY: OLWR


284

K-...

The sketch below only required for water wells

If well telescopes, show depths on sketch.

Ground Level →

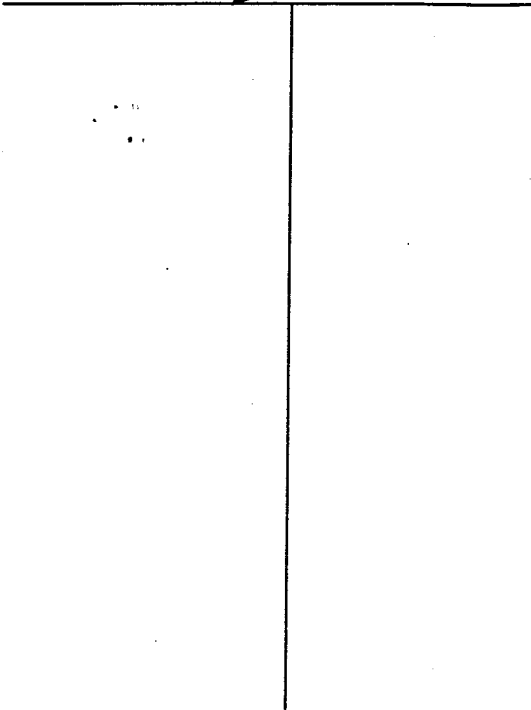


Description of formations encountered must be provided for all wells and boreholes, unless specifically exempted by regulations

Description of Formations Encountered	From (depth)	To (depth)
	Ground Level	
CLAY	0	13
Med Sand	13	33
COARSE SAND + GRAVEL	33	110

If more than one screen, show location of each on sketch

Sketch the property layout and include the following: 1) the well location; 2) any permanent structures on the property that may aid in locating the well; 3) any roads, power lines, or other items that may aid in locating the property and the well; 4) a north arrow.

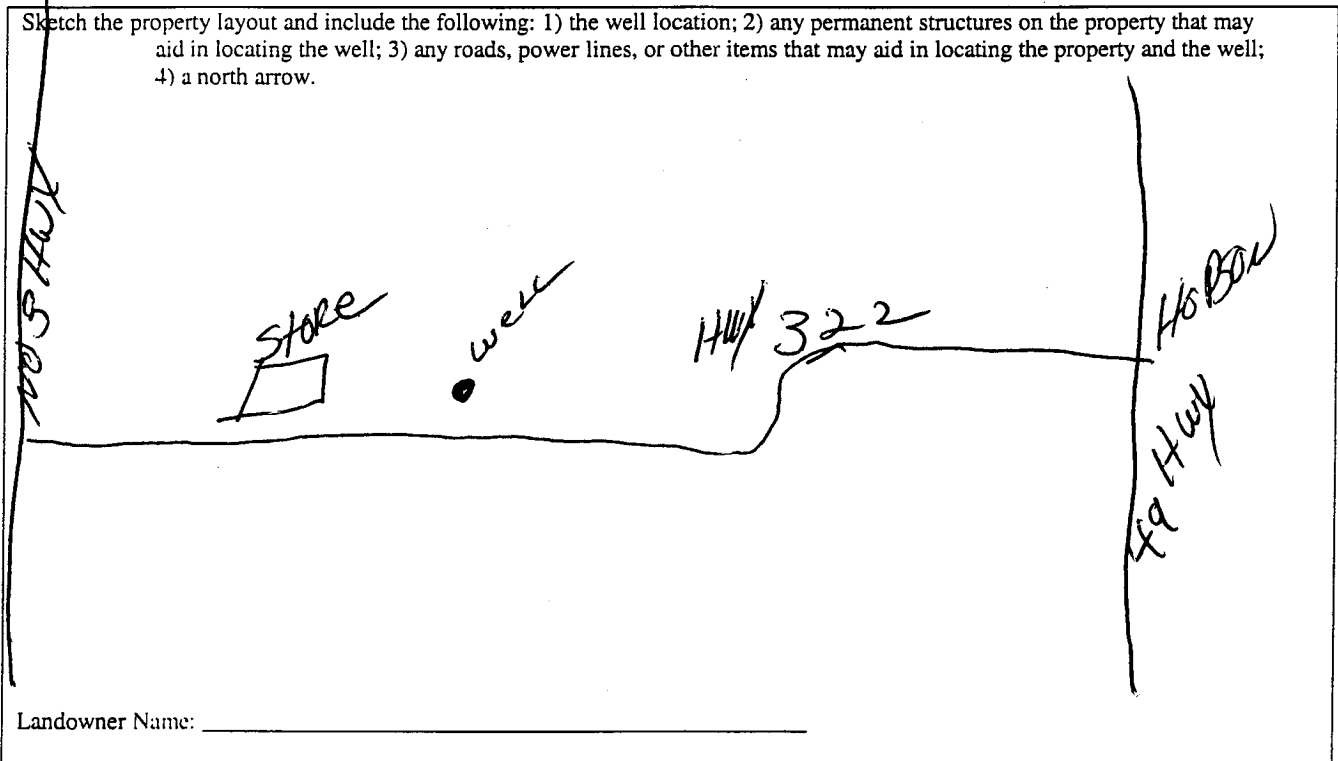

Landowner Name: _____

I certify that the well/borehole was drilled, constructed, and completed in accordance with all applicable requirements of the Mississippi Department of Environmental Quality and the Mississippi Department of Health regulations, if applicable, and state laws.

PAUL POWELL 0485
Print Name of Responsible Licensee and License No.

7/11/05
Date

Paul Powell
Signature of Licensee

STATE WELL REPORT

Part 2

Pump Installer's Completion Report
 Mississippi Department of Environmental Quality
 Office of Land and Water Resources
 P.O. Box 10631
 Jackson, MS 39289-0631
 (601)961-5210
 (601)354-6938 (fax)

County: QUITMAN
 Permit #: 40505
 Driller: HOUSTON DRILLING
 Date completed: 6/22
Copy information from block on Part 1

For Office Use Only:

Aquifer: _____
 Well #: K-84
 Elevation: _____

This part of the report must be completed by a licensed water well contractor or a licensed pump installer. A copy of Part 1 of the report must be attached and both parts filed with the Department at the above address within 30 days of well completion.

Well Owner Information	Well Location
Owner Name: <u>MICHEL WAHLS</u>	Latitude: <u>34° 09' 63" N</u> Longitude: <u>090° 21' 01" W</u>
Mailing Address: <u>CLARKSDALE MS</u> <u>38614</u>	Method of Lat/Long (check one): Conventional Survey _____ USGS quad _____, Hand-held GPS <input checked="" type="checkbox"/> , Survey-grade GPS _____ _____ 1/4 _____ 1/4 Sec _____ T _____ R _____
City State Zip Code	Distance Direction Nearest Town
Telephone No. (_____) _____	_____ Miles _____ of _____

Pump Type Circle one	Power Type Circle one
Air Lift Jet <u>Submersible</u>	Diesel Engine Gasoline Engine Natural Gas
Bucket Piston Turbine	<u>Electric Motor</u> Hand Tractor PTO
Centrifugal Rotary Flowing Well	Windmill Other (specify): _____
Other (specify): _____	Horse Power Rating of Motor: _____
Date Pump Installed: <u>6/22</u>	Setting Depth: <u>60</u> feet
Rated Pump Capacity: <u>1200</u> Gallons Per Minute	Number of Stages: <u>1</u>

Pump Test Data	Method of Measuring Water Level Circle one
Date Well Tested: _____	Air Line Electric Measuring Line <u>Steel Tape</u>
Static Water Level (A): <u>19</u> Feet Below Land Surface	Other (specify): _____
Pumping Water Level (B): _____ Feet Below Land Surface	For flowing well, measured shut in head: _____ feet
Drawdown [(B) - (A)]: _____ Feet Below Land Surface	Well yielded _____ GPM with a drawdown of _____ feet after _____ hours of pumping
Test Pumping Rate: _____ Gallons Per Minute	
Duration of Pump Test (minimum 4 hours): _____ hours	

I HEREBY CERTIFY that the above statements are true to the best of my knowledge.

PAUL Powell 0435 RECEIVED RECEIVED
 Print Name of Pump Installer and License No. (if applicable) Signature of Pump Installer

SEP 12 2005 JUL 28 2005
 BY: OLWR BY: OLWR