	. State Wo	ell Report			
State Well Report		For Office Use Only:			
County: Quit Man	Part 1 – Driller's Log		Aquifer:		
01102	Mississippi Department of Environmental Quality Office of Land and Water Resources		1		
	P.O. Box 10631		Well #:		
Driller: Del Jumper			L. S. Elevation:		
1 10/16	Jackson, MS 39289-0631 (601)961-5210		E. D. Blovadon		
Date drilling completed: 4/9/00		-6938 (fax)	E-log #:		
	. ` ′				
State Law requires that this report be prepared by the license holder responsible for the work and filed with the Department at the above address within 30 days of completion of drilling of the well or borehole.					
Information on Well	Owner	Well or Bo	orehole Location		
(Landowner if borehole is not f	for a water well)	211 1/2 200	2" Longitude 00 23,311"		
1	. 11 . 1	Latitude: 37° US 300	2" Longitude 10 00 01		
Owner Name	rantham	Method of Lat/Long (circle o	ne): Conventional Survey.		
$\frac{1}{1}$ $\frac{1}{1}$ $\frac{1}{1}$ $\frac{1}{1}$ $\frac{1}{1}$ $\frac{1}{1}$ $\frac{1}{1}$	Method of Lavlong (chick				
Mailing Address:	USGS quad, riand-nei		1 GPS, Survey-grade GPS		
-0	h = 0m/ m/	SW1/2 NE 1/2 Sec 10	Twn O6 N Rng OW		
L Kategville	MS KUDO	<u> </u>			
<u> </u>	ate Zip Code	Distance Direction	Nearest Town		
1		Miles S	of Camper		
Telephone No. (Lobal) 609-16	49				
Well / Borehole Data					
1 Males			24		
Date drilling started:	Irilling completed: 6 H	Hole depth:	Hole diameter:		
Location of the source of any surface water used for drilling: Supply Wild of desires and volume of Chloring used in drilling and development:					
Location of the source of any surface wa	iter used for drilling:	lonment:			
Method of dosing and volume of Chicama does in driving					
Logs run (circle all applicable): No log r	Electric Gamma Ray	Density Sonic Neutron	Other:		
Logs run (circle all applicable): No log run Electric Gamma Ray Density Sonic Neutron Other: Name of organization running log(s):					
Purpose of borehole (check one): Water WellGeotechnical/Geological Investigation Ground Source Heat Pump					
Color (Asserta					
Seismic Survey Other (aescribe)					
Purpose of Well (check one): Home Industrial Public Supply Irrigation_ Fish Culture Other:					
If a flowing well, method of flow regulation: Valve Other (describe)					
Static Water Level:feet above or below (circle one) land surface Date measured:					
Method of Measurement (circle one) steel tape electric tape air line other:					
Well depth: Well grouted to a depth of Seet Type of grout (circle one): Neat Cement Bentonite Mix					
Casing length: 75 feet Casing diameter:inches Type of casing:					
Screen length:					
Screen slot size:inches Setting depth: From					
Type of completion (circle all applicable) Gravel packed Underreamed Telescoped Open hole Natural Development					

Other (describe): _

Top of lap pipe or reduction in casing: _______feet. If telescoped or more than one screen, describe on next page

RECENTED

AUG 07 2006 BY: OLWP

K-89

The sketch below only required for water wells


If well telescopes, show depths on sketch

40' Scrow & 75' 16' pue casigo
140' Scrow & 75' 16' pue casigo
140' Single skg2 50' 10" Satting

Description of formations ancountered must be provided for all needs and boreholes, unless specifically exempted by regulations

From (depth)	To (depth)
Ground Level	
D	45
45	50
J-℃	115
	<u> </u>
	Ļ
	J
	<u> </u>
	From (depth) Ground Level 45 5-0

If more than one screen, show location of each on sketch

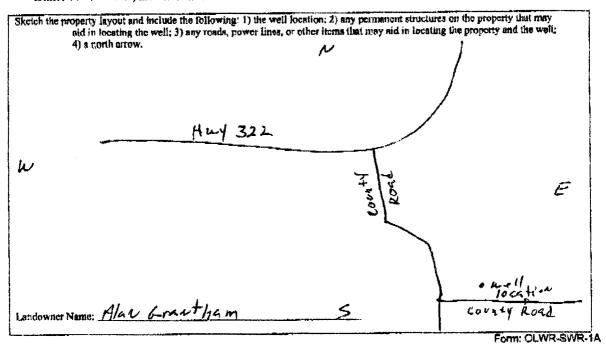

I certify that the well/borehole was drilled, constructed, and completed in accordance with all applicable requirements of the Mississippi Department of Environmental Quality and the Mississippi Department of Health regulations, if applicable, and state

Print Name of Responsible Lawrence and Liconse No. Date Signature of Licensee AUG 07 2006

BY: OLWR

STATE WELL REPORT Part 2 County: For Office Use Only: Pump Installer's Completion Report Mississippi Department of Environmental Quality Permit# Aquifer: Office of Land and Water Resources P.O. Box 10631 Well #: Jackson, MS 39289-0631 Date completed: (601)961-5210 (601)354-6938 (fax) Copy information from block on Part 1 This part of the report must be completed by a licensed water well contractor or a licensed pump installer. A copy of Part 1 of the report must be attached and both parts filed with the Department at the above address within 30 days of well completion. Well Owner Information Well Location Latitude: 34 08 300 Longitude: Owner Name: Method of Lat/Long (check one): Conventional Survey Mailing Address: USGS quad . Hand-held GPS , Survey-grade GPS Direction Distance Nearest Town Telephone No. (Power Type Pump Type Circle one Circle one Air Lift Submersible Diesel Engine Gasoline Engine Jet Natural Gas Bucket Piston Turbine Electric Motor Hand Tractor PTO Centrifugal Rotary Flowing Well Windmill Other (specify): _ Horse Power Rating of Motor: Other (specify): _ Date Pump Installed: Setting Depth: Rated Pump Capacity: ___ Gallons Per Minute Number of Stages: _ Pump Test Data Method of Measuring Water Level Circle one Date Well Tested: Air Line **Electric Measuring Line** Steel Tape Static Water Level (A): Feet Below Land Surface Other (specify): _ Pumping Water Level (B): 35 Feet Below Land Surface Feet Below Land Surface Drawdown [(B) - (A)]: For flowing well, measured shut in head: _ 3500 Gallons Per Minute Test Pumping Rate: _ GPM with a drawdown of Well vielded Duration of Pump Test (minimum 4 hours): _ _feet after ____ hours of pumping

I HEREBY CERTIFY that the above statements are true to the best of	of my knowledge.	RECEIVED
Print Name of Pump Installer and License No. (if applicable)	Signature of Pump Installer	AUG 0 7 2006
		Form: OLWR-SWR-1B