

Part 2 never received

Job # 9440

County: Quitman
 Permit #: _____
 Driller: Pete Sappington
 Date drilling completed: 11-09-09

4/13
State Well Report
Part 1 - Driller's Log
 Mississippi Department of Environmental Quality
 Office of Land and Water Resources
 P.O. Box 2309
 Jackson, MS 39225
 (601)961-5210
 (601)961-5228 (fax)

For Office Use Only:
 Aquifer: K 102
 Well #: _____
 L. S. Elevation: _____
 E-log #: _____

State Law requires that this report be prepared by the license holder responsible for the work and filed with the Department at the above address within 30 days of completion of drilling of the well or borehole.

Information on Well Owner (Landowner if borehole is not for a water well)	Well or Borehole Location
Owner Name: <u>Buckskin Farms Chris Talley</u>	Latitude: <u>34° 09' 37"</u> Longitude: <u>90° 22' 57"</u>
Mailing Address: <u>489 Highway 3</u>	Method of Lat/Long (circle one): <u>Conventional Survey</u>
<u>Tutaviler Miss. 38693</u>	USGS quad, Hand-held GPS, Survey-grade GPS
City State Zip Code	<u>NE 1/4 NE 1/4 Sec 3 Twn 26N Rng 2W</u>
Telephone No. <u>(662) 645-5663</u>	Distance <u>5 1/2</u> Miles Direction <u>SW</u> of Nearest Town <u>Lambert, Ms.</u>

Well / Borehole Data

Date drilling started: 11-09-09 Date drilling completed: 11-9-09 Hole depth: 92' Hole diameter: 28"

Location of the source of any surface water used for drilling: From Smaller Well Nearby

Method of dosing and volume of Chlorine used in drilling and development: Sodium Hypo Chlorite @ 10 ppm

Logs run (circle all applicable): No log run Electric Gamma Ray Density Sonic Neutron Other: _____

Name of organization running log(s): _____

Purpose of borehole (check one): Water Well Geotechnical/Geological Investigation _____ Ground Source Heat Pump _____

Seismic Survey _____ Other (describe) _____

If drilling is not related to water well construction, skip the remainder of this block

Purpose of Well (check one): Home _____ Industrial _____ Public Supply _____ Irrigation Fish Culture _____ Other: _____

If a flowing well, method of flow regulation: Valve _____ Other (describe) _____

Static Water Level: 15' feet above or below (circle one) land surface Date measured: 11-9-09

Method of Measurement (circle one) steel tape electric tape air line other: _____

Well depth: 92' Well grouted to a depth of 10 feet Type of grout (circle one): Neat Cement Bentonite Mix

Casing length: 52 feet Casing diameter: 16 inches Type of casing: PVC Sch 40

Screen length: 40 feet Screen diameter: 16 inches Type of screen: PVC Sch 40

Screen slot size: .032 inches Setting depth: From 52 feet to 92 feet

Type of completion (circle all applicable): Gravel packed Underreamed Telescoped Open hole Natural Development

Other (describe): _____

Top of lap pipe or reduction in casing: _____ feet. *If telescoped or more than one screen, describe on next page*

Form: OLWR-SWR-1A (04/08)

RECEIVED
 NOV 24 2009
 BY: OLWR

090° 23' 30.00" W

090° 23' 00.00" W


090° 22' 30.00" W

K102

034° 10' 00.00" N

034° 09' 30.00" N

034° 09' 00.00" N

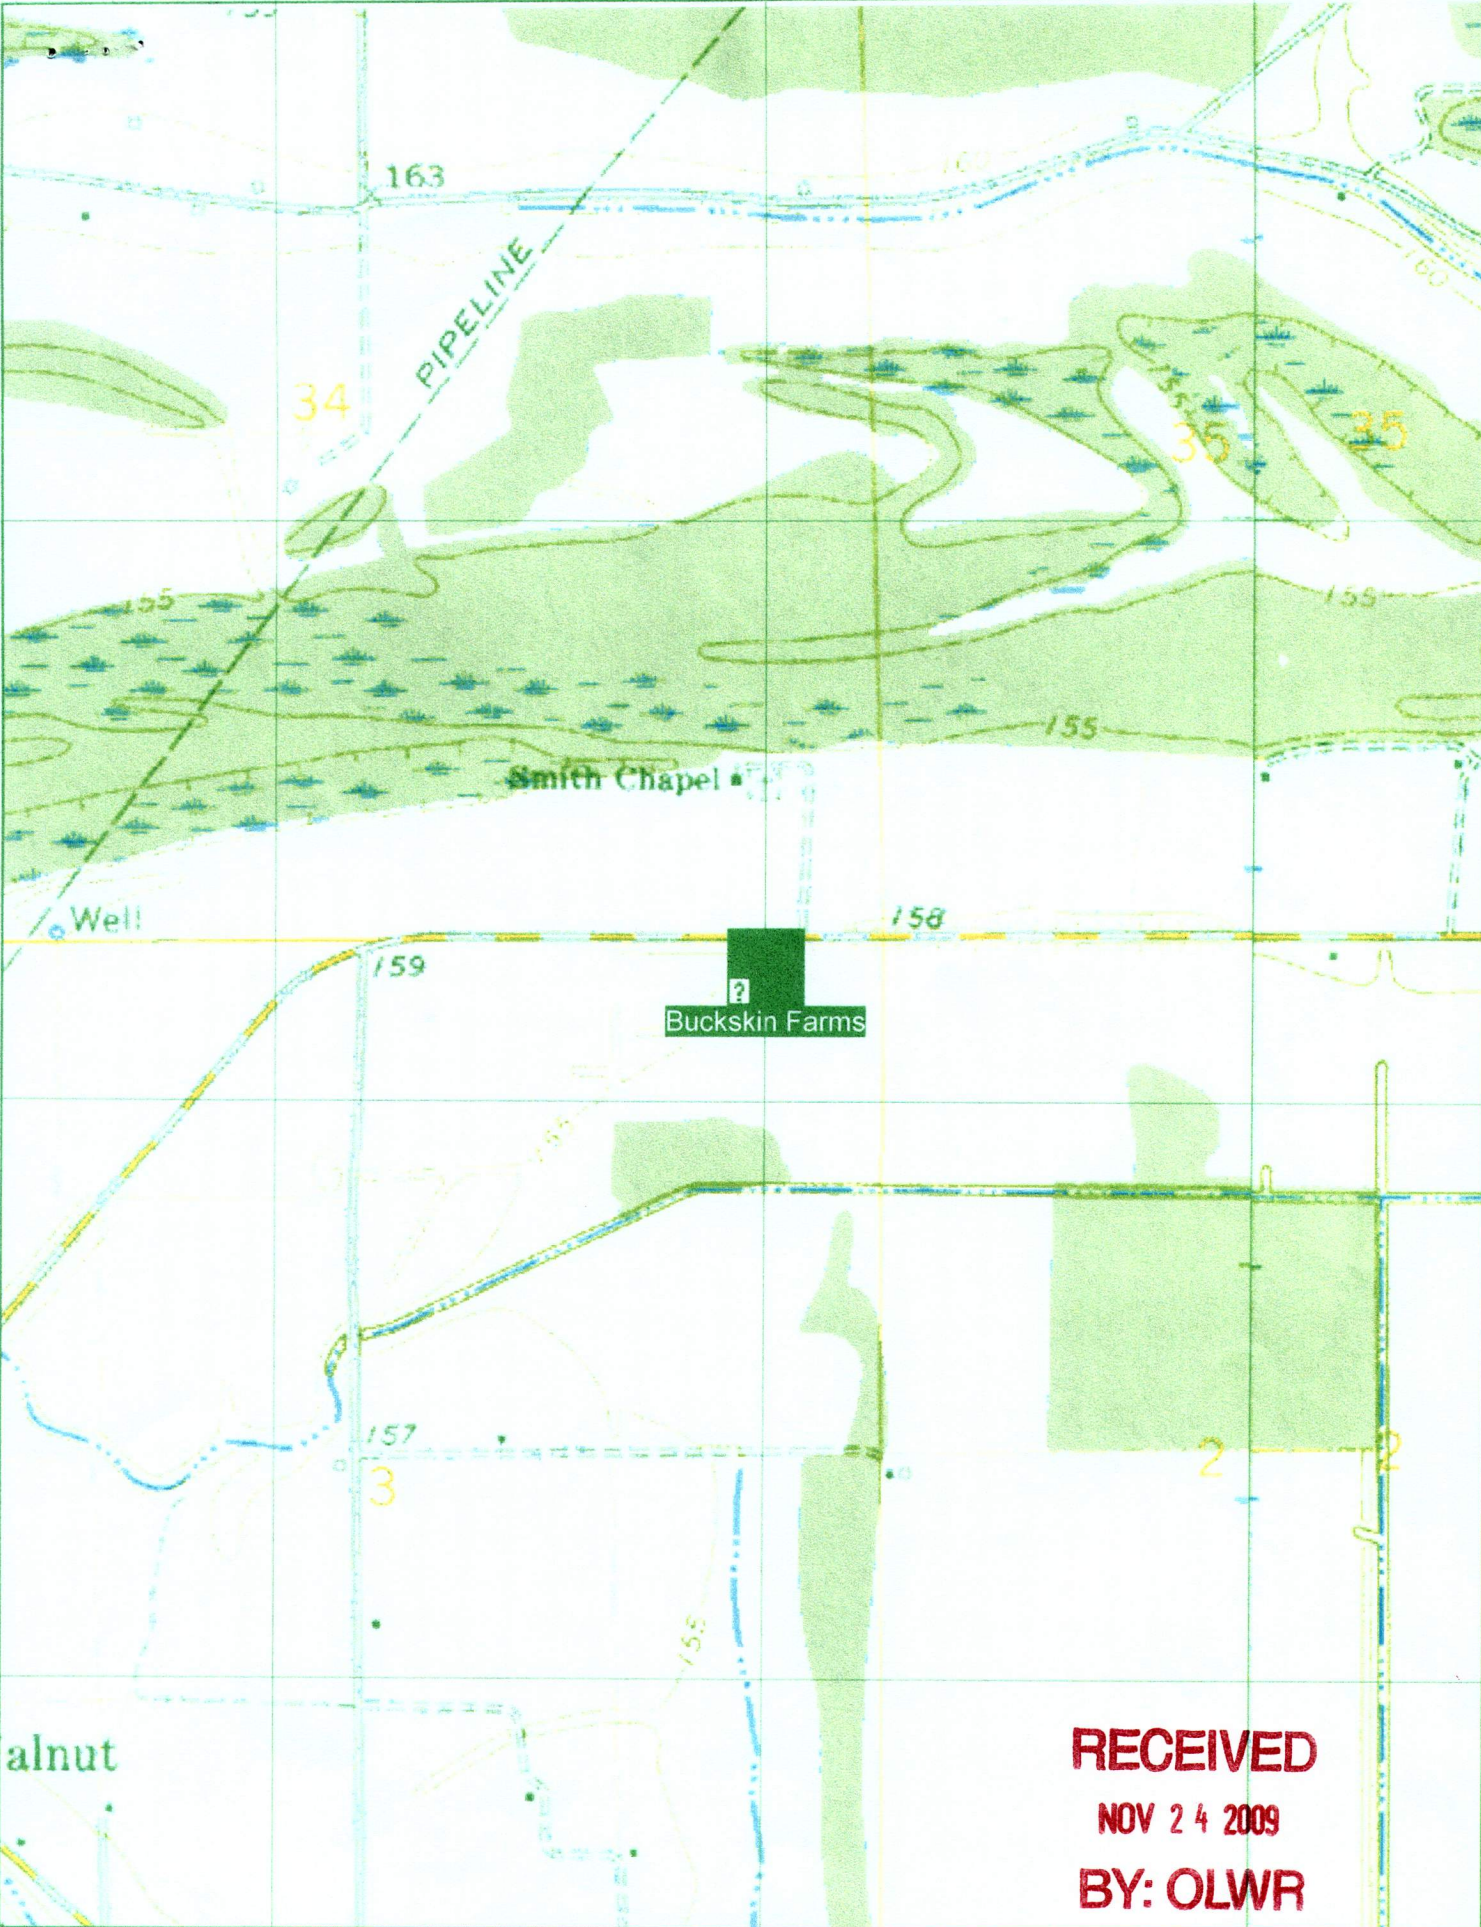

alnut

RECEIVED

NOV 24 2009

BY: OLWR

090° 23' 30.00" W

090° 23' 00.00" W

090° 22' 30.00" W