

QUITMAN

MISSISSIPPI BOARD OF WATER COMMISSIONERS

J 2000

6-10-66

WATER WELL DRILLERS LOG

Date 6-10, 1966, Driller: J. B. Cain County Panola

(Name)

(1) Owner of Land: Billy Helms  
Crowder Miss  
(Name)  
(Address)

Description & Color of Materials  
Sand, Clay, Red Clay, Shells, etc.  
Bro Clay  
Lane  
Thickness Feet  
0 18  
18 65  
Depth Feet

(2) Location: 1/4, 1/4, Sec. 26 T24R1E  
1/2 miles NW of Crowder  
(distance) (direction) (Nearest Town)

(3) Topography:  Level  
(Hilly) (Flat) (Level)

(4) Purpose of Well:  
(Domestic Irrigation  
Municipal, Industrial, Other)

Information upon completion of well:

(1) Diameter 2 inches.

(2) Total Depth 65 feet.

(3) Water Level 12 feet below top of ground.

(4) Cased to 65, Size 2"


(5) Screen: Size 3, Length 5  
Gravel Packed

(6) Were any formations sealed against pollution?  
yes, no.

If YES depth of formation

Why

Drillers Remarks:  
Screen Glued  
on

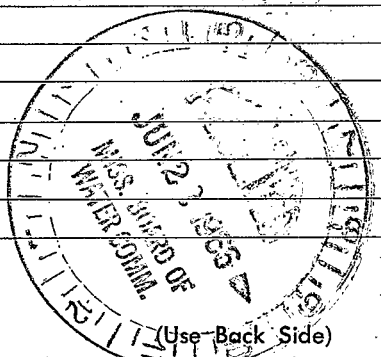

Well No.

