

Guitman
 TALLAHATCHIE
 A. 2003
 K 2003

MISSISSIPPI DEPARTMENT OF NATURAL RESOURCES
 Bureau of Land and Water Resources
 Southport Mall
 P.O. Box 10631
 Jackson, Mississippi 39209
 WATER WELL DRILLERS LOG

6 19 87 date well completed
 Powell IRR, Inc firm name
 Tallahatchie county well located

LANDOWNER:
 Jim Wilbourn
 Clarksdale MS 38619
 (mailing address)

description of formations encountered	from to	
Clay	0	23
FINE SAND	23	43
COARSE SAND	43	103

WELL LOCATION:
 32 sec 26 N 5 E R 2 OK
 5 miles W of VANCE
 (distance) (direction) (nearest town)

WELL PURPOSE: IRR
 (home, irrigation, municipal, industrial)

WELL COMPLETION DATA:

(1) diameter (inches) 10

(2) total depth (feet) 103

(3) static water level (feet) 14 below top of ground.

(4) casing Steel, 103
 (material) (depth)

(size) If telescope see back.

(5) screen 40, 63
 (length) (depth to top)

10, Steel
 (size) (material)

(6) pump 30 1500
 (HP) (yield gpm)

Diesel
 (type power)

(7) electric log _____
 (yes or no)

(organization running log)

(8) how well bottom plugged Steel Plate

RECEIVED


JUL 27 1987

Department of Natural Resources
 Bureau of Land & Water Resources

DRILLERS REMARKS:

If well telescopes please sketch and show depths.

GROUND LEVEL

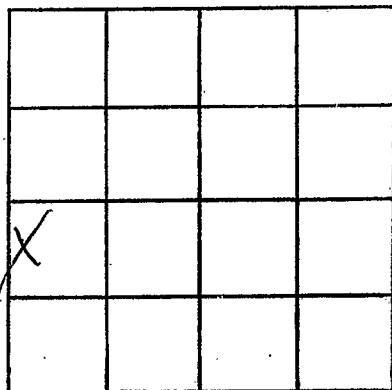

SECTION 35

Please indicate well location X.

ADDITIONAL INFORMATION

If more than one screen,
show locations of each on sketch.