

MISSISSIPPI  
BOARD OF WATER COMMISSIONERS  
416 North State Street  
Jackson, Mississippi 39201

**CODED**

WATER WELL DRILLERS LOG

Quitman  
L 25  
2-11-69

2-11 1969 J. B. Cain Quitman  
date well completed firm name county well located

LANDOWNER: W. C. WINSON  
Miss  
(mailing address)

description of formations encountered	from	to
<u>Hard Cl</u>	<u>0</u>	<u>20</u>
<u>Sand</u>	<u>20</u>	<u>30</u>
<u>Sh + Sand</u>	<u>30</u>	<u>180</u>
<u>Blue Cl</u>	<u>180</u>	<u>320</u>
<u>Sand &amp; Cl. Shuff</u>	<u>320</u>	<u>701</u>
<u>Sand</u>	<u>701</u>	<u>760</u>
<u>Blue Cl Sand &amp;</u>	<u>760</u>	<u>803</u>

WELL LOCATION:  
sec. 27 T 26 N R T E W W  
7 miles S of Quitman  
(distance) (direction) (nearest town)

WELL PURPOSE:  
(home, irrigation, municipal, industrial)

- WELL COMPLETION DATA:
- (1) diameter (inches) 4 x 3
  - (2) total depth (feet) 963
  - (3) static water level (feet) Flow below/above top of ground.
  - (4) casing: M 744  
(material) (depth)  
4 x 3 If telescope see back.  
(size)
  - (5) screen 30 714  
(length) (depth to top)  
3" Standard S  
(size) (material)
  - (6) pump \_\_\_\_\_  
(HP) (yield gpm)  
(type power)
  - (7) electric log \_\_\_\_\_  
(yes or no)  
(organization running log)
  - (8) how well bottom plugged wash B

**CODED**

**CODED**


APR 4 1969

MISS. Bd. of  
WATER COMMISSIONERS

DRILLERS REMARKS:

If well telescopes please sketch and show depths.

GROUND LEVEL

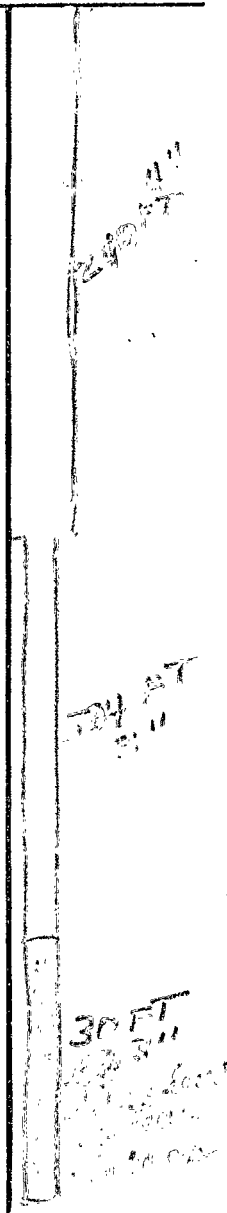

			X 27

SECTION 27

Please indicate well location X.

ADDITIONAL INFORMATION

If more than one screen, show locations of each on sketch.