

*L28*  
5-20-65

WATER WELL DRILLERS LOG

**CODED**

Date: 5-20, 1965, Driller: Gerry Roberson County Panola  
(Name)

(1) Owner of Land: Thomas Mitchell  
(Name)  
Samburg, Miss  
(Address)

(2) Location: 1/4, 1/4, Sec. 4 T26R1W  
3 miles South of Samburg  
(distance) (direction) (Nearest Town)

(3) Topography: Level  
(Hilly) (Flat) (Level)

(4) Purpose of Well: Home  
(Domestic Irrigation  
Municipal, Industrial, Other)

Description & Color of Materials Sand, Clay, Red Clay, Shell, etc.	Thick- ness Feet	Depth Feet
<u>Clay + sand</u>	<u>0</u>	<u>100</u>
<u>White Clay</u>	<u>100</u>	<u>300</u>
<u>Sand + Clay</u>	<u>300</u>	<u>600</u>
<u>Sand</u>	<u>600</u>	<u>800</u>

Information upon completion of well:

(1) Diameter 2 inches.

(2) Total Depth 800 feet.

(3) Water Level flowing feet below top of ground.

(4) Cased to 780, Size 2


(5) Screen: Size 2in, Length 20ft

(6) Were any formations sealed against pollution?  
\_\_\_\_\_ yes, \_\_\_\_\_ no.

If YES depth of formation \_\_\_\_\_  
Why \_\_\_\_\_

Drillers Remarks: Steel well

*Steel well*  
**CODED**

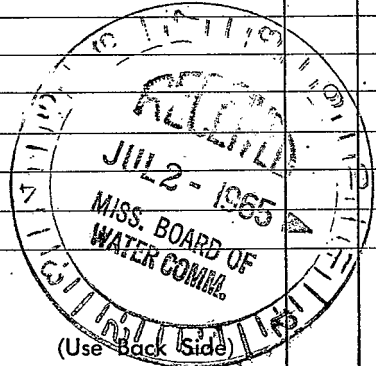

Well No.

100

100

100