

Quitman  
L30

MISSISSIPPI BOARD OF WATER COMMISSIONERS

8-25-66

WATER WELL DRILLERS LOG **CODED**

Quitman

Date: 8 25, 1966, Driller: FIVE COUNTY FARMERS County: Quitman  
(Name)


(1) Owner of Land: JC WINDHAM  
(Name)  
VANCE MISS  
(Address)

(2) Location: NE 1/4, SW 2/4, Sec. 7 T12R11W  
2 1/8 miles NORTH of VANCE  
(distance) (direction) (Nearest Town)

(3) Topography: Flat  
(Hilly) (Flat) (Level)

(4) Purpose of Well: Irrigation  
(Domestic Irrigation Municipal, Industrial, Other)

Description & Color of Materials Sand, Clay, Red Clay, Shell, etc.	Thick- ness Feet	Depth Feet
<u>Clay</u>		<u>33 1/2</u>
<u>FINE SAND</u>	<u>13</u>	<u>46 1/2</u>
<u>Coarse Sand</u>	<u>19 1/2</u>	<u>66</u>
<u>Coarse Sand &amp; Shells</u>	<u>52</u>	<u>118</u>
<u>Clay</u>		<u>124</u>
<u>White Sand &amp; Shells</u>		<u>131</u>

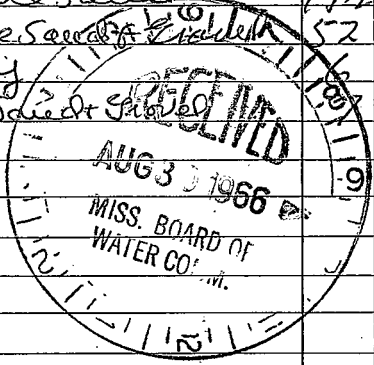

Information upon completion of well:

(1) Diameter 14 inches.

(2) Total Depth 123' 4" feet.

(3) Water Level 15' 10" feet below top of ground.

(4) Cased to 74' 8", Size 14"

(5) Screen: Size 14", Length 48'

(6) Were any formations sealed against pollution?  
 yes,  no.

**CODED**

If YES depth of formation \_\_\_\_\_

Why \_\_\_\_\_

Drillers Remarks: \_\_\_\_\_

Well No.

(Use Back Side)

