

QUITMAN
L32
3-22-75

MISSISSIPPI
 BOARD OF WATER COMMISSIONERS
 416 North State Street
 Jackson, Mississippi 39201

CODED

WATER WELL DRILLERS LOG


March 22, 1975 Singer-Layne Central Div. ⁰⁶⁴ Quitman
 date well completed firm name county well located

LANDOWNER:	description of formations encountered	from	to
Vandell Brothers Vance, Miss. (mailing address)			
WELL LOCATION: sec. 4 T 26 N R 1 W 3 miles West of Vance (distance) (direction) (nearest town)			
WELL PURPOSE: irrigation (home, irrigation, municipal, industrial)			
WELL COMPLETION DATA:			
(1) diameter (inches) 16"			
(2) total depth (feet) 104'			
(3) static water level (feet) 15 below ^{below} top of ground.			
(4) casing steel 54' (material) (depth) 16" if telescope see back. (size)			
(5) screen 50' 54' (length) (depth to top) 1.6" steel (size) (material)			
(6) pump 50 2000 (HP) (yield gpm) engine (type power)			
(7) electric log no (yes or no) (organization running log)			
(8) how well bottom plugged with plate			
DRILLERS REMARKS:			

RECEIVED
 MAY 19 1975

If well telescopes please sketch and show depths.

GROUND LEVEL

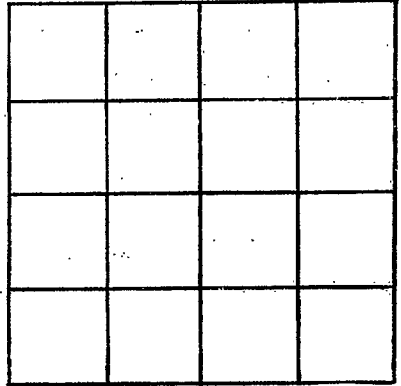

SECTION _____

Please indicate well location X.

ADDITIONAL INFORMATION

If more than one screen, show locations of each on sketch.