

Quitman
L 33
7-24-75

MISSISSIPPI
BOARD OF WATER COMMISSIONERS
416 North State Street
Jackson, Mississippi 39201


COPY

WATER WELL DRILLERS LOG

7-24 1975 Lipe Well Co. Quitman
date well completed firm name county well located

LANDOWNER:	description of formations encountered	from	to
U.S. Post office Vance Miss. (mailing address)	Top Soil SAND	0 20	20 75
WELL LOCATION:			
sec. <u>36</u> T <u>26</u> N <u>15</u> S R <u>1</u> E <u>15</u> W 8 miles south of Lamber (distance) (direction) (nearest town)			
WELL PURPOSE:			
(home, irrigation, <u>municipal</u> , industrial)			
WELL COMPLETION DATA:			
(1) diameter (inches) <u>4</u>			
(2) total depth (feet) <u>73</u>			
(3) static water level (feet) <u>10</u> below above top of ground.			
(4) casing <u>PVC</u> , <u>63</u> (material) (depth)			
<u>4</u> If telescope see back. (size)			
(5) screen <u>10</u> , <u>63</u> (length) (depth to top)			
<u>4</u> , <u>PVC</u> (size) (material)			
(6) pump <u>3/4</u> , <u>10</u> (HP) (yield gpm)			
<u>elec.</u> (type power)			
(7) electric log <u>no</u> (yes or no)			
<u>no</u> (organization running log)			
(8) how well bottom plugged <u>PVC</u> <u>plug</u>			
DRILLERS REMARKS:			

CODED

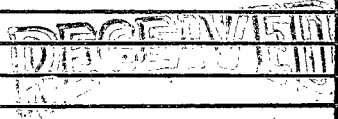

AUG 5 1975

