

QUITMAN

L 34

6-8-79

MISSISSIPPI BOARD OF WATER COMMISSIONERS
416 North State Street
Jackson, Mississippi 39201

CODED

WATER WELL DRILLERS LOG

6-8

date well completed

1979 Five Co. Farmer Ass

firm name

Quitman

county well located

LANDOWNER: Frank Melton

description of formations encountered

from

to

Brazil Mine

(mailing address)

WELL LOCATION:

sec 33 T 26 N R 1 E S W

3 miles east of Vance
(distance) (direction) (nearest town)

WELL PURPOSE:

(home, irrigation, municipal, industrial)

WELL COMPLETION DATA:

- (1) diameter (inches) 16"
- (2) total depth (feet) 117'
- (3) static water level (feet) 17' below top of ground.

(4) casing steel, 60' (material) (depth)

(size) if telescope see back.

(5) screen 50' length, 60' depth to top
16" size, steel screen (material)

(6) pump 60 (HP), 3200 (yield gpm)
diesel (type power)

(7) electric log no (yes or no)

(organization running log)

(8) how well bottom plugged welded

DRILLERS REMARKS:


Miss. Board of Water Comm.

AUG 6 1979

RECEIVED

If well telescopes please sketch and show depths.

GROUND LEVEL

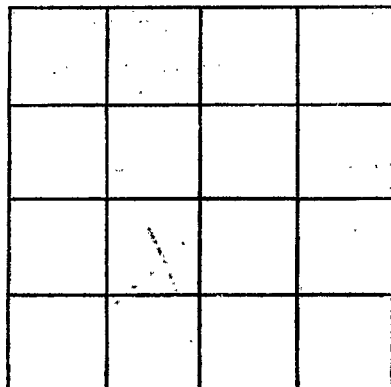

SECTION 27

Please indicate well location X.

ADDITIONAL INFORMATION

If more than one screen,
show locations of each on sketch.