

CODED

MISSISSIPPI  
BOARD OF WATER COMMISSIONERS  
416 North State Street  
Jackson, Mississippi 39201

QUITMAN
L 35
6-9-79

WATER WELL DRILLERS LOG

6-9-1979 date well completed      Fier Co. Farmers arm firm name      Quitman county well located

LANDOWNER: <u>Rayman Trainor</u> <u>Lambert Min</u>	description of formations encountered	from	to
(mailing address)	<u>top clay</u>	0	12
WELL LOCATION:	<u>fine sand</u>	12	22
sec <u>1</u> T <u>26</u> N S R <u>1</u> E W	<u>coarse sand</u>	22	45
4 miles <u>south</u> of <u>Lambert</u> (distance) (direction) (nearest town)	<u>sand &amp; gra</u>	45	112
WELL PURPOSE: (home, irrigation, municipal, industrial)	CODED		
WELL COMPLETION DATA:			
(1) diameter (inches) <u>16"</u>			
(2) total depth (feet) <u>112'</u>			
(3) static water level (feet) <u>12</u> <sup>below</sup> / <sub>above</sub> top of ground.			
(4) casing <u>steel</u> <u>62'</u> (material) (depth)			
_____ if telescope see back. (size)			
(5) screen <u>50'</u> <u>62'</u> (length) (depth to top)			
<u>16"</u> <u>steel screen</u> (size) (material)			
(6) pump <u>60</u> <u>3200</u> (HP) (yield gpm)			
<u>direct</u> (type power)			
(7) electric log <u>no</u> (yes or no)			
_____ (organization running log)			
(8) how well bottom plugged <u>well</u>			
DRILLERS REMARKS:			


Miss. Board of Water Comm.

AUG 6 1979

RECEIVED

If well telescopes please sketch and show depths.

GROUND LEVEL

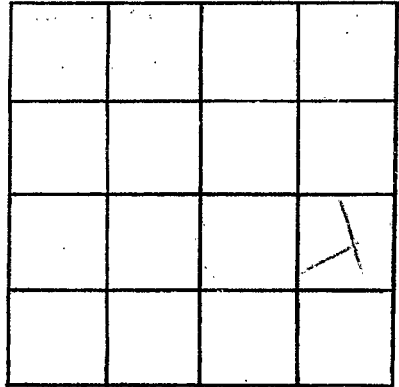

SECTION 1

Please indicate well location X.

ADDITIONAL INFORMATION

If more than one screen,  
show locations of each on sketch.