

MISSISSIPPI DEPARTMENT OF NATURAL RESOURCES

Bureau of Land and Water Resources

Southport Mall

P.O. Box 10631

Jackson, Mississippi 39201

WATER WELL DRILLERS LOG

CODED

Quitman

L 36

2-16-81

2/16/81

date well completed

19

Dyer

firm name


Quitman

county well located

LANDOWNER:	description of formations encountered	from	to
RE R.E. PINION, JR	sand	23	33
Lambert, MS. (mailing address)	sand	33	43
WELL LOCATION:	sand	43	53
sec. <u>22</u> T. <u>26</u> S. R. <u>1</u> E. <u>W</u> <u>6</u> miles <u>5</u> of <u>Lambert</u> (distance) (direction) (nearest town)	sand & gravel	53	63
WELL PURPOSE: <u>Irrigation</u> (home, irrigation, municipal, industrial)	sand & gravel	63	73
WELL COMPLETION DATA:	sand & gravel	73	83
(1) diameter (inches) <u>16"</u>	gravel	83	93
(2) total depth (feet) <u>108'</u>	gravel	93	103
(3) static water level (feet) <u>19'</u> below top of ground.	gravel	103	108
(4) casing <u>Steel</u> <u>108'</u> (material) (depth)			
<u>16"</u> if telescopic see back. (size)			
(5) screen <u>40'</u> <u>68'</u> (length) (depth to top)			
<u>16"</u> <u>Steel</u> (size) (material)			
(6) pump <u>60</u> <u>3000</u> (HP) (yield gpm)			
<u>propane</u> (type power)			
(7) electric log _____ (yes or no)			
(organization running log)			
(8) how well bottom plugged <u>plate</u>			
DRILLERS REMARKS:			

CODED



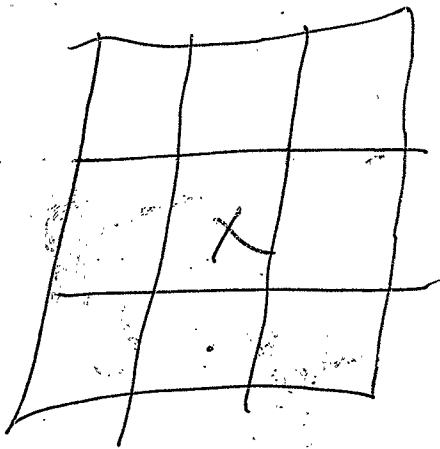

sec 22