

MISSISSIPPI DEPARTMENT OF NATURAL RESOURCES

Bureau of Land and Water Resources

Southport Mall

P.O. Box 10631

Jackson, Mississippi 39209

WATER WELL DRILLERS LOG

0050

CODED

Quitman

L38

2-10-81

date well completed

19 81

film name

Dyer

county well located

Quitman

LANDOWNER:

MAVIS COBB

Lambert, MS.

(mailing address)

WELL LOCATION:

sec 21 T 26 S R 1 E
 4 miles S of Lambert
 (distance) (direction) (nearest town)

WELL PURPOSE:

Irrigation
 (home, irrigation, municipal, industrial)

WELL COMPLETION DATA:

- (1) diameter (inches) 16
- (2) total depth (feet) 112'
- (3) static water level (feet) 20' below top of ground
- (4) casing Steel 112' (material) (depth)
 16" (size) if telescopic see back.
- (5) screen 40' 72' (length) (depth to top)
 16" Steel (size) (material)
- (6) pump 60 3000 (HP) (yield gpm)
 Diesel (type power)
- (7) electric log (yes or no)
- (8) how well bottom plugged plate


description of formations encountered

from


to

clay	23	33
clay	33	43
clay	43	53
clay & gravel	53	63
clay & gravel	63	73
clay & gravel	73	83
clay & gravel	83	93
gravel	93	103
gravel	103	112

CODED

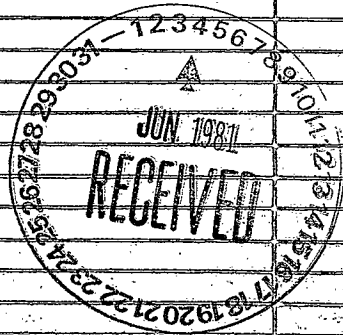

DRILLERS REMARKS:

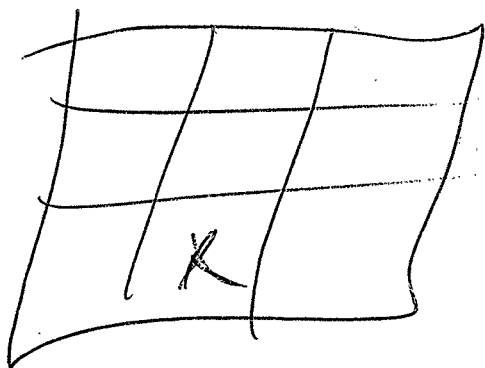

Sec 21