

MISSISSIPPI DEPARTMENT OF NATURAL RESOURCES
Bureau of Land and Water Resources
 Southport Mall **CODED**
 P.O. Box 10631
 Jackson, Mississippi 39209
WATER WELL DRILLERS LOG

L4
Quitman
05-01-84

date well completed 19 84 firm name J & K Irrigation & Well county well located Quitman

LANDOWNER:
Ray Crawford
Lambert, Miss.
 (mailing address)

description of formations encountered	from	to
<u>CLAY</u>	<u>0</u>	<u>21</u>
<u>FINE SAND</u>	<u>21</u>	<u>35</u>
<u>SAND gravel</u>	<u>35</u>	<u>103</u>

WELL LOCATION:
 sec. 28 T. 26 N. R. 1 E.
5 miles S of Lambert
 (distance) (direction) (nearest town)

WELL PURPOSE:
 (home, irrigation, municipal, industrial)

- WELL COMPLETION DATA:**
- diameter (inches) 16
 - total depth (feet) 103
 - static water level (feet) 8 below above top of ground.
 - casing steel (material), 63 (depth)
16 (size) if telescope see back.
 - screen 40 (length), 63 (depth to top)
16 (size), steel (material)
 - pump 125 (HP), 1800 (yield gpm)
diesel (type power)
 - electric log no (yes or no)
- (organization running log)
- (8) how well bottom plugged plate

DRILLERS REMARKS:


DEPT. OF NATURAL RESOURCES
 BUREAU OF LAND & WATER RESOURCES

MAY 31 1984

RECEIVED

If well telescopes please sketch and show depths.

GROUND LEVEL

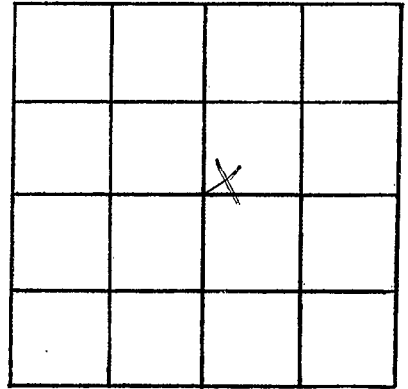

SECTION 28th

Please indicate well location X.

ADDITIONAL INFORMATION

If more than one screen, show locations of each on sketch.