

MISSISSIPPI DEPARTMENT OF NATURAL RESOURCES
Bureau of Land and Water Resources
 Southport Mall
 P.O. Box 10631
 Jackson, Mississippi 39209
WATER WELL DRILLERS LOG

CODED

243
Quitman
05-01-84

date well completed 19 84 firm name J & K Irrigation & Well county well located Quitman

LANDOWNER:	description of formations encountered	from	to
<u>Ray Crawford</u>	<u>CLAY</u>	<u>0</u>	<u>23</u>
<u>Lambert Miss.</u> (mailing address)	<u>FINE SAND</u>	<u>23</u>	<u>42</u>
	<u>SAND GRAVEL</u>	<u>42</u>	<u>103</u>

WELL LOCATION:
 sec. 32 T. 26 N. R. 1 E.
 S. (W)
6 1/2 miles S of Lambert
 (distance) (direction) (nearest town)

WELL PURPOSE:
 (home, irrigation, municipal, industrial)
irrigation

- WELL COMPLETION DATA:**
- diameter (inches) 12
 - total depth (feet) 103
 - static water level (feet) 8 ^{below} above top of ground.
 - casing steel, 63,
 (material) (depth)
12 if telescope see back.
 (size)
 - screen 40, 63
 (length) (depth to top)
12
 (size)
 - pump 60, 1100
 (HP) (yield gpm)
diesel
 (type power)
 - electric log no
 (yes or no)

(organization running log)


(8) how well bottom plugged plate

DRILLERS REMARKS:

MISSISSIPPI DEPARTMENT OF NATURAL RESOURCES
 BUREAU OF LAND AND WATER RESOURCES
 MAY 31 1984
 RECORDED & INDEXED

If well telescopes please sketch and show depths.

GROUND LEVEL

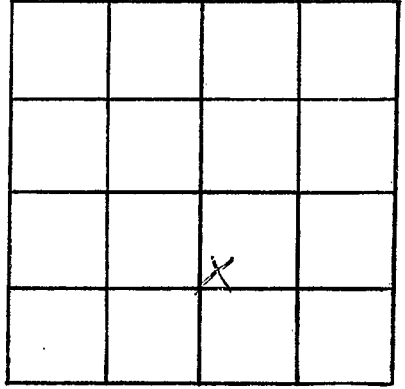

SECTION 32

Please indicate well location X.

ADDITIONAL INFORMATION

If more than one screen, show locations of each on sketch.