

MISSISSIPPI DEPARTMENT OF NATURAL RESOURCES

Bureau of Land and Water Resources

Southport Mall

P.O. Box 10631

COBED

Jackson, Mississippi 39209

WATER WELL DRILLERS LOG

L44  
 Quitman  
 05-01-84

date well completed 19 84 firm name J+K Irrigation Well county well located Quitman

LANDOWNER:  
Ray Crawford  
Lambert, Miss.  
 (mailing address)

| description of formations encountered | from      | to         |
|---------------------------------------|-----------|------------|
| <u>CLAY</u>                           | <u>0</u>  | <u>13</u>  |
| <u>CLAY</u>                           | <u>13</u> | <u>23</u>  |
| <u>LINE STAY</u>                      | <u>23</u> | <u>42</u>  |
| <u>SAND &amp; GRAVEL</u>              | <u>42</u> | <u>103</u> |

WELL LOCATION:  
 sec 36 T 26 N R 1 E  
5 miles SW of Dance  
 (distance) (direction) (nearest town)

WELL PURPOSE:  
 (home, irrigation, municipal, industrial)  
irrigation

WELL COMPLETION DATA:

(1) diameter (inches) 12

(2) total depth (feet) 103

(3) static water level (feet) 8 <sup>below</sup> <sub>above</sub> top of ground.

(4) casing steel (material), 63 (depth),  
12 (size) if telescope see back.

(5) screen 40 (length), 63 (depth to top),  
12 (size), steel (material)

(6) pump 80 (HP), 1200 (yield gpm),  
diesel (type power)

(7) electric log no (yes or no)

(organization running log) \_\_\_\_\_

(8) how well bottom plugged plate

DEPT. OF NATURAL RESOURCES  
 BUREAU OF LAND & WATER RESOURCES


MAY 31 1984

RECEIVED

DRILLERS REMARKS:

If well telescopes please sketch and show depths.

GROUND LEVEL

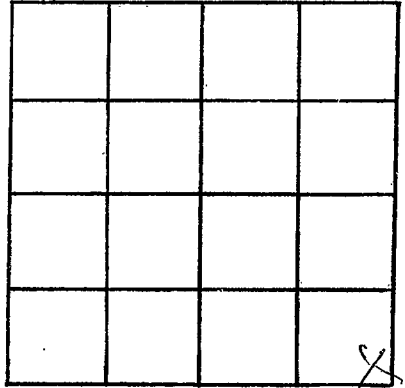

SECTION 36

Please indicate well location X.

ADDITIONAL INFORMATION

If more than one screen,  
show locations of each on sketch.