

MISSISSIPPI DEPARTMENT OF NATURAL RESOURCES  
 Bureau of Land and Water Resources  
 Southport Mall  
 P.O. Box 10631  
 Jackson, Mississippi 39209  
**WATER WELL DRILLERS LOG**

L45  
 Quitman Co  
 6-14-84

**CODED**

6/14 1984 Powell Irrigation Quitman  
 date well completed firm name county well located

LANDOWNER:  
R. A. CARSON  
 (mailing address)

description of formations encountered	from	to
CLAY	0	20
Coarse sand	20	60
GRAVEL + SAND	60	100

WELL LOCATION:  
 sec. 7 T 26N S R 1 E  
5 miles SW of Lambert  
 (distance) (direction) (nearest town)

WELL PURPOSE: Irrigation  
 (home, irrigation, municipal, industrial)

- WELL COMPLETION DATA:
- (1) ~~diameter~~ (inches) 12"
  - (2) total depth (feet) 100'
  - (3) static water level (feet) 14' <sup>below</sup> above top of ground.
  - (4) casing Steel, 60'  
 (material) (depth)  
 \_\_\_\_\_ if telescope see back.  
 (size)
  - (5) screen 40', 60'  
 (length) (depth to top)  
12", Steel  
 (size) (material)
  - (6) pump 80 1400  
 (HP) (yield gpm)  
direct  
 (type power)
  - (7) electric log NO  
 (yes or no)  
 \_\_\_\_\_  
 (organization running log)
  - (8) how well bottom plugged  
Steel plate

DRILLERS REMARKS:


**CODED**

DEPT. OF NATURAL RESOURCES  
 BUREAU OF LAND & WATER RESOURCES

JUL 10 1984  
**RECEIVED**

If well telescopes please sketch and show depths.

GROUND LEVEL

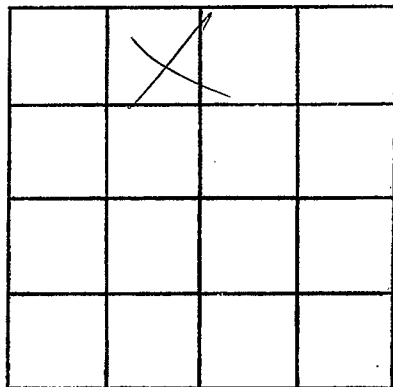

SECTION 2

Please indicate well location X.

ADDITIONAL INFORMATION

If more than one screen,  
show locations of each on sketch.