

MISSISSIPPI DEPARTMENT OF NATURAL RESOURCES
Bureau of Land and Water Resources
 Southport Mall
 P.O. Box 10631
 Jackson, Mississippi 39209
WATER WELL DRILLERS LOG

L46
 Quitman Co.
 6-15-84

CODED

6/15 1984 Powell Irrigation Quitman
 date well completed firm name county well located

LANDOWNER:	description of formations encountered	from	to
R.A. CARSON (mailing address)	CLAY	0	20
WELL LOCATION: sec. 6 T. 26(N) S R. 1 E (W)	Coarse sand	20	60
5 miles SW of Lambert (distance) (direction) (nearest town)	Gravel + sand	60	100
WELL PURPOSE: Irrigation (home, irrigation, municipal, industrial)	CODED		
WELL COMPLETION DATA:			
(1) diameter (inches) 12"			
(2) total depth (feet) 100'			
(3) static water level (feet) 14' ^{below} above top of ground.			
(4) casing <u>Steel</u> <u>60'</u> (material) (depth)			
_____ If telescope see back. (size)			
(5) screen <u>40'</u> <u>60'</u> (length) (depth to top)			
<u>12"</u> <u>Steel</u> (size) (material)			
(6) pump <u>80</u> <u>1400</u> (HP) (yield gpm)			
<u>diesel</u> (type power)			
(7) electric log <u>NO</u> (yes or no)			
_____ (organization running log)			
(8) how well bottom plugged <u>Steel Plate</u>			
DRILLERS REMARKS:			


DEPT. OF NATURAL RESOURCES
 BUREAU OF LAND & WATER RESOURCES

JUL 10 1984

RECEIVED

If well telescopes please sketch and show depths.

GROUND LEVEL

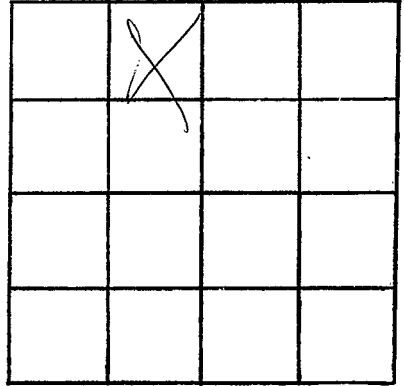

SECTION 6

Please indicate well location X.

ADDITIONAL INFORMATION

If more than one screen,
show locations of each on sketch.