

MISSISSIPPI DEPARTMENT OF NATURAL RESOURCES

Bureau of Land and Water Resources

Southport Mall

P.O. Box 10631

CODED

Jackson, Mississippi 39209

WATER WELL DRILLERS LOG

L48
Quirtman
7-15-84

7/84 19 Powell Irrigation Quirtman  
 date well completed firm name county well located

LANDOWNER:  
E. O. Vance  
 (mailing address)

description of formations encountered	from	to
<u>CLAY</u>	<u>0</u>	<u>10</u>
<u>MED &amp; COARSE SAND</u>	<u>10</u>	<u>40</u>
<u>COARSE SAND &amp; GRAVEL</u>	<u>40</u>	<u>100</u>

WELL LOCATION:  
 sec. 31 T. 26 N. R. 1 E. S. 1 W.  
1 miles NE of VANCE  
 (distance) (direction) (nearest town)

WELL PURPOSE: IRRIGATION  
 (home, irrigation, municipal, industrial)

WELL COMPLETION DATA:

(1) diameter (inches) 12

(2) total depth (feet) 100

(3) static water level (feet) 15 below above top of ground.

(4) casing Steel 60  
 (material) (depth)  
 (size) if telescope see back.

(5) screen 40 60  
 (length) (depth to top)  
12 Steel  
 (size) (material)

(6) pump 80 1500  
 (HP) (yield gpm)  
Diesel  
 (type power)

(7) electric log No  
 (yes or no)  
 (organization running log)

(8) how well bottom plugged  
Steel Plate

DRILLERS REMARKS:


DEPT. OF NATURAL RESOURCES  
 BUREAU OF LAND & WATER RESOURCES

NOV 29 1984

RECEIVED

If well telescopes please sketch and show depths.

GROUND LEVEL

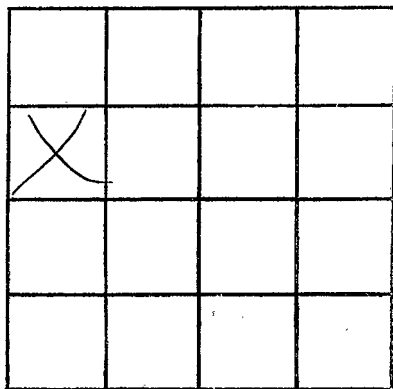

SECTION 31

Please indicate well location X.

ADDITIONAL INFORMATION

If more than one screen,  
show locations of each on sketch.