

MISSISSIPPI DEPARTMENT OF NATURAL RESOURCES

Bureau of Land and Water Resources

Southport Mall

P.O. Box 10631

Jackson, Mississippi 39209

WATER WELL DRILLERS LOG

CODED

Quitman
L 49

06-01
date well completed

87 Powell DR, INC
firm name

Quitman
county well located

LANDOWNER:	description of fomations encountered	from	to
Mrs. Helen Corbin Lambert, MS 38643 (mailing address)		CLAY FINE SAND COARSE SAND	0 23 53
WELL LOCATION:	CODED		
sec. 9 T. 26 N R. 1 W 4 miles N-E of Vance (distance) (direction) (nearest town)			
WELL PURPOSE: (home, irrigation, municipal, industrial)	FRK		
WELL COMPLETION DATA:			
(1) diameter (inches) 12			
(2) total depth (feet) 103			
(3) static water level (feet) 16 below above top of ground.			
(4) casing Steel, 63 (material) (depth)			
(size) if telescope see back.			
(5) screen 40, 63 (length) (depth to top)			
12, Steel (size) (material)			
(6) pump 40 1800 (HP) (yield gpm)			
diesel (type power)			
(7) electric log (yes or no)			
(organization running log)			
(8) how well bottom plugged Steel Plate			

RECEIVED


JUN 26 1987

Department of Natural Resources
Bureau of Land & Water Resources

DRILLERS REMARKS:

If well telescopes please sketch and show depths.

GROUND LEVEL

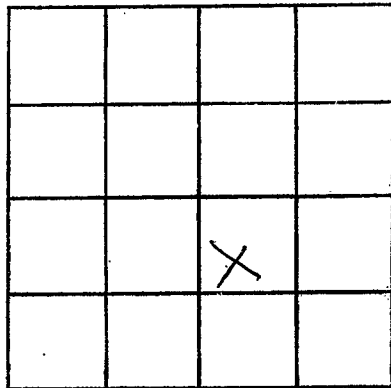

SECTION 9

Please indicate well location X.

ADDITIONAL INFORMATION

Horizontal lines for additional information.

If more than one screen, show locations of each on sketch.