

MISSISSIPPI DEPARTMENT OF NATURAL RESOURCES

Bureau of Land and Water Resources

Southport Mall

P.O. Box 10631

Jackson, Mississippi 39209 CODED

WATER WELL DRILLERS LOG

QUITMAN  
L 50

08-91 (9) 19  
date well completed

87 Powell L&L, Inc  
firm name

Quitman  
county well located

LANDOWNER:  
Jim Wilbourn  
CLARKSDALE, MS 38614  
(mailing address)

description of formations encountered	from	to
<u>CLAY</u>	<u>0</u>	<u>23</u>
<u>FINE SAND</u>	<u>23</u>	<u>63</u>
<u>COARSE SAND &amp; GRAVEL</u>	<u>63</u>	<u>110</u>

WELL LOCATION:  
sec. 32 T. 36 N. R. 1 E. (W)  
2 miles E of VANCE  
(distance) (direction) (nearest town)

WELL PURPOSE: FW  
(home, irrigation, municipal, industrial)

- WELL COMPLETION DATA:
- (1) diameter (inches) 16
  - (2) total depth (feet) 110
  - (3) static water level (feet) 16 below above top of ground.
  - (4) casing Steel, 110  
(material), (depth)
  - if telescope see back.  
(size)
  - (5) screen 40, 70  
(length), (depth to top)
  - 16, Steel  
(size), (material)
  - (6) pump 200, 2200  
(HP), (yield gpm)
  - Diesel  
(type power)
  - (7) electric log           
(yes or no)
  - (organization running log)
  - (8) how well bottom plugged Steel  
PLATE

CODED


RECEIVED  
AUG 03 1997

Department of Natural Resources  
Bureau of Land & Water Resources

DRILLERS REMARKS:

If well telescopes please sketch and show depths.

GROUND LEVEL

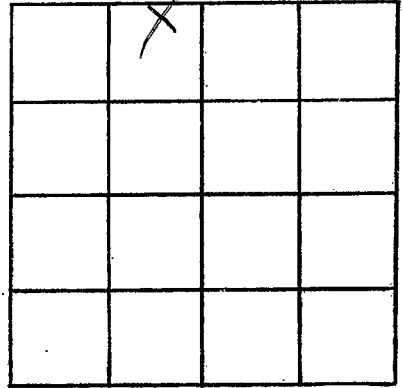

SECTION 32

Please indicate well location X.

ADDITIONAL INFORMATION

If more than one screen,  
show locations of each on sketch.