

State Well Report

Part I

Mississippi Department of Environmental Quality
Office of Land and Water Resources
P.O. Box 10631
Jackson, MS 39289-0631
(601)961-5210
(601)354-6938 (fax)

For Office Use Only:

Aquifer: _____
Well #: L-65
L.S. Elevation: _____
E-log #: _____

County: QUITMAN
Permit #: 6W 41860
Driller: Delta Drilling
Date drilling completed: 5-28-07

State Law requires that this report be prepared by the driller in detail and filed with the Department within 30 days of completion of drilling of the well.

Well Owner Information	Well Location
Owner Name: <u>Ray Crawford</u>	Latitude: <u>34° 05' 26.5"</u> Longitude: <u>90° 14' 04.5"</u>
Mailing Address: <u>225 Crawford Rd</u>	Method of Lat/Long (circle one): <u>Conventional Survey</u>
<u>Jarbert</u> MS <u>38671</u>	USGS quad: <u>Hand-held OPS</u> , Survey-grade GPS <u>1</u>
City State Zip Code	<u>NW 1/4 NE 1/4 Sec 26 Twn 26 Rng 2 W</u>
Telephone No. <u>(662) 356-4411</u>	Distance <u>7</u> Miles <u>S</u> Direction of <u>Jarbert</u> Nearest Town

Well Data

Purpose of Well (circle one) Home Industrial Public Supply Irrigation Fish Culture Other: _____

Date well drilling started: 5-28-07 Date well drilling completed: 5-28-07

If flowing, method of flow regulation: Valve _____ Other (describe) _____

Static Water Level: 22 feet above or below (circle one) land surface Date measured: 5-29-07

Method of Measurement (circle one) steel tape electric tape air line other: _____

Hole depth: 100 Well depth: 100 Well grouted to a depth of 10 feet

Type of grout (circle one): Cement Bentonite Mix

Casing length: 60 feet Casing diameter: 12 inches Type of casing: PVC

Screen length: 40 feet Screen diameter: 12 inches Type of screen: PVC

Screen slot size: 32 inches Setting depth: From 60 feet to 100 feet

Type of completion (circle all applicable): Gravel packed Underreamed Telescoped Open hole Natural Development

Other (describe): _____

Top of lap pipe or reduction in casing: _____ feet. If telescoped or more than one screen, describe on back of page

Logs run (circle all applicable): No log run Electric Gamma Ray Density Sonic Neutron Other: VISUAL

Name of organization running log(s): _____

I certify that the well was drilled, constructed, and completed in accordance with all applicable requirements of the Mississippi Department of Environmental Quality and/or the Mississippi Department of Health regulations and state laws.

ALAN PYLE 0674
Print Name of Water Well Contractor and License No.

[Signature]
Signature of Water Well Contractor


If well telescopes please sketch below and show depths.

Ground Level: 6641860

Description of Formations Encountered	From	To
Clay	0	60
Coarse Sand	60	80
Gravel	80	100

If more than one screen, show location of each on sketch

Sketch the property layout and include the following: 1) the well location; 2) any permanent structures on the property that may aid in locating the well; 3) any roads, power lines, or other items that may aid in locating the property and the well; 4) indicate direction.

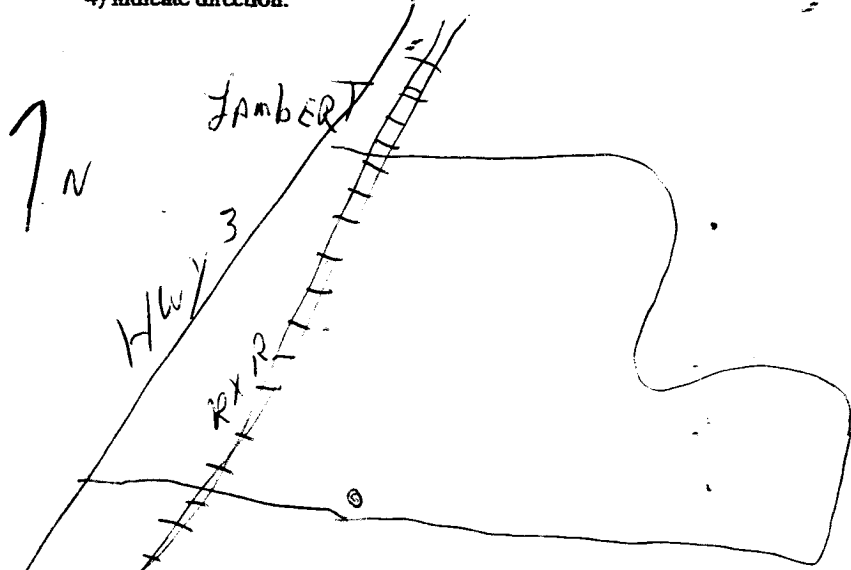

Landowner Name: Ray Crawford

[Signature]
 Signature of Watch Well Contractor

STATE WELL REPORT

Part 2

Pump Installer's Completion Report
Mississippi Department of Environmental Quality
Office of Land and Water Resources
P.O. Box 10631
Jackson, MS 39289-0631
(601)961-3210
(601)354-6938 (fax)

For Office Use Only:

Acquifer: _____
Well #: L-65
Elevation: _____

County: OSHTMAN
Permit #: 66W42860
Driller: Dale Dullin
Date completed: 5-29-07

This report should be prepared by the pump installer in detail and filed with the Department within 30 days of the installation of pump.

Well Owner Information	Well Location
Owner Name: <u>Ray Crawford</u>	Latitude: <u>34-05 26S</u> Longitude: <u>090 14 90W</u>
Mailing Address: <u>225 Crawford Rd</u>	Method of Lat/Long (circle one): <input type="checkbox"/> Conventional Survey, <input checked="" type="checkbox"/> USGS quad, <input checked="" type="checkbox"/> Hand-held GPS, <input type="checkbox"/> Survey-grade GPS
<u>Lawford MS 38671</u>	<input type="checkbox"/> 1/4 <input type="checkbox"/> 1/2 Sec. <input type="checkbox"/> Twp. <input type="checkbox"/> Rng.
City State Zip Code	Distance Direction Nearest Town
Telephone No. <u>662 326-4411</u>	Miles of

Pump Type Circle one	Power Type Circle one
Air Lift Jet Submersible	Diesel Engine Gasoline Engine Natural Gas
Bucket Piston <input checked="" type="checkbox"/> Turbine	<input checked="" type="checkbox"/> Electric Motor Hand Tractor PTO
Centrifugal Rotary Flowing Well	Windmill Other (specify): _____
Other (specify): _____	Horse Power Rating of Motor: <u>30</u>
Date Pump Installed: <u>5-29-07</u>	Setting Depth: <u>60</u> feet
Rated Pump Capacity: <u>1700</u> Gallons Per Minute	Number of Stages: _____

Pump Test Data	Method of Measuring Water Level Circle one
Date Well Tested: _____	Air Line Electric Measuring Line Steel Tape
Static Water Level (A): _____ Feet Below Land Surface	Other (specify): _____
Pumping Water Level (B): _____ Feet Below Land Surface	For flowing well, measured shut in head: _____ feet
Drawdown [(B) - (A)]: _____ Feet Below Land Surface	Well yielded _____ GPM with a drawdown of _____ feet after _____ hours of pumping
Test Pumping Rate: _____ Gallons Per Minute	
Duration of Pump Test (minimum 4 hours): _____ hours	

I HEREBY CERTIFY that the above statements are true to the best of my knowledge.

ALAN PYLE _____
Print Name of Pump Installer and License No. (if applicable) Signature of Pump Installer