

QUITMAN
M 24
6-15-71

MISSISSIPPI
 BOARD OF WATER COMMISSIONERS
 416 North State Street
 Jackson, Mississippi 39201

CODED

WATER WELL DRILLERS LOG

6-15 1971 FIVE COUNTY FARMERS ASSN QUITMAN
 date well completed firm name county well located

LANDOWNER: W.A. CRAWFORD

description of formations encountered	from	to
---------------------------------------	------	----

LAMBERT Miss
 (mailing address)

CLAY	0	14
CLAY	14	20 1/2
SAND	20 1/2	27
SAND	27	33 1/2
SAND	33 1/2	40
SAND	40	46 1/2
SAND	46 1/2	53
SAND : GRAVEL	53	59 1/2
SAND : GRAVEL	59 1/2	66
SAND : GRAVEL	66	72 1/2
SAND : GRAVEL	72 1/2	79
SAND : GRAVEL	79	85 1/2
SAND : GRAVEL	85 1/2	92
SAND : GRAVEL	92	98 1/2
SAND : GRAVEL	98 1/2	105

WELL LOCATION:
 sec. 29 T. 26 N. R. 1 E.
9 miles SE of LAMBERT
 (distance) (direction) (nearest town)

WELL PURPOSE: IRRIGATION
 (home, irrigation, municipal, industrial)

WELL COMPLETION DATA:

- (1) diameter (inches) 6"
- (2) total depth (feet) 105'
- (3) static water level (feet) 10' below top of ground.
- (4) casing SCHEDULE 40 57'
 (material) (depth)
6" If telescope see back.
 (size)
- (5) screen 48' 57'
 (length) (depth to top)
6" DOERE
 (size) (material)
- (6) pump HANKS 1400
 (HP) (yield gpm)
 (type power)
- (7) electric log No
 (yes or no)
 (organization running log)
- (8) how well bottom plugged WELDED

CODED


JUL 15 1971

MISS. RD. OF
 WATER COMM.

DRILLERS REMARKS:

If well telescopes please sketch and show depths.

GROUND LEVEL

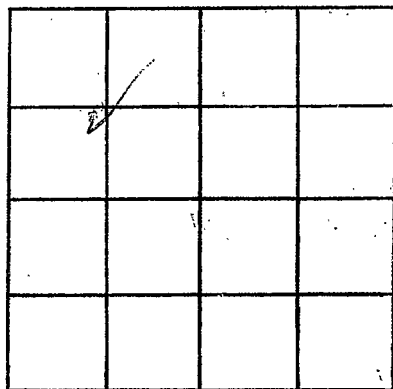

SECTION _____

Please indicate well location X.

ADDITIONAL INFORMATION

If more than one screen, show locations of each on sketch.