

MISSISSIPPI
BOARD OF WATER COMMISSIONERS
416 North State Street
Jackson, Mississippi 39201

CODED 1/69

WATER WELL DRILLERS LOG

CODED

Quitman
M 25
10-8-68

Oct 8th 1968 date well completed
Luther Ratliff firm name
Quitman county well located

LANDOWNER: James William Lambert, mess

(mailing address)

WELL LOCATION:

sec 5 T 26 N R 1 E
5 miles South of Lambert
(distance) (direction) (nearest town)

WELL PURPOSE:

Home
(home, irrigation, municipal, industrial)

WELL COMPLETION DATA:

- (1) diameter (inches) 2"
- (2) total depth (feet) 840'
- (3) static water level (feet) flowing ^{below} top of ground.
- (4) casing Galvnl 840'
(material) (depth)
(size) If telescope see back.
- (5) screen 20 , 820
(length) (depth to top)
2" , stainless
(size) (material)
- (6) pump _____ (HP) _____ (yield gpm)
(type power)
- (7) electric log no
(yes or no)
(organization running log)
- (8) how well bottom plugged fresh water
water

Description of formations encountered	from	to
top soil	0	23
sand	23	83
gravel	83	143
sand	143	203
clay	203	263
sand	263	323
shale	323	413
sand	413	483
shale	483	603
sand	603	633
shale	633	663
sand	663	753
shale	753	773
sand	773	840

CODED

DRILLERS REMARKS:

JAN - 69

MISSISSIPPI
BOARD OF WATER COMMISSIONERS

If well telescopes please sketch and show depths.

GROUND LEVEL

2" Well


820 feet

2" Pipe

20 feet

2" Screen

840

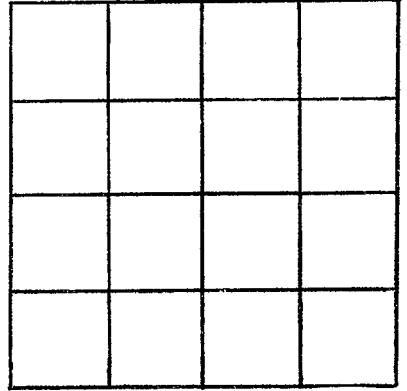

SECTION 5

Please indicate well location X.

ADDITIONAL INFORMATION

If more than one screen, show locations of each on sketch.