

Quitman  
M26  
3-16-65

MISSISSIPPI BOARD OF WATER COMMISSIONERS

James A. Ligo  
WATER WELL DRILLERS LOG

**CODED**

Date: 3.16, 1965, Driller: Frank Taylor County Quitman  
(Name)

(1) Owner of Land: W. A. Crofford  
(Name)  
Lambert, Miss  
(Address)

(2) Location: 1/4, 1/4, Sec. 32 T 26 R E  
10 miles So of Lambert  
(distance) (direction) (Nearest-Town)

(3) Topography: flat  
(Hilly) (Flat) (Level)

(4) Purpose of Well: Domestic  
(Domestic Irrigation  
Municipal, Industrial, Other)

Description & Color of Materials Sand, Clay, Red Clay, Shell, etc.	Thick- ness Feet	Depth Feet
Top Soil	0	23
Sand	23	103
Clay and sand	103	123
" "	123	143
" "	143	163
Sand	163	183
" "	183	203
" "	203	223
Clay and sand	223	243
Clay sand & Rock	243	263
Clay	263	283
Black shaly sand	283	303
Sand and gumbo	303	323
Gumbo shale & sand	323	343
" " "	343	363
" " "	363	383
Sand and Shale	383	403
Sand & gumbo	403	423
" "	423	443
" "	443	463
" "	463	483
Sand good	483	503
Sand good	503	523
Sand good	523	543
Good	543	563
sand	563	582

Information upon completion of well:

(1) Diameter 2 1/2 inches.

(2) Total Depth 582 feet.

(3) Water Level flowing feet below top of ground.


(4) Cased to 562, Size 2 1/2

(5) Screen: Size 2 1/2, Length 20'

(6) Were any formations sealed against pollution?  
\_\_\_\_\_ yes, \_\_\_\_\_ no.

If YES depth of formation \_\_\_\_\_  
Why \_\_\_\_\_

Drillers Remarks: Cut 6" Rock  
103' Cut 8" Rock  
at 243'

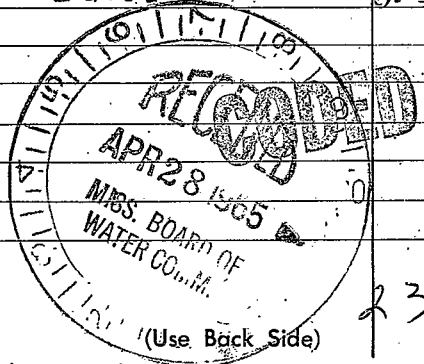

Well No. 23

