

QUITMAN
M 27
9-17-70

MISSISSIPPI
BOARD OF WATER COMMISSIONERS
416 North State Street
Jackson, Mississippi 39201

CODED

WATER WELL DRILLERS LOG

9-17-70 1970 Five County Farmers Quitman
date well completed firm name county well located

LANDOWNER:
Noel Wilborn
Lambert, Miss.
(mailing address)

description of formations encountered	from	to
<u>Box Gail</u>		<u>14</u>
<u>Clay</u>	<u>14</u>	<u>21</u>
<u>Thin Sand</u>	<u>21</u>	<u>46</u>
<u>Coarse Sand + Pea rock</u>	<u>46</u>	<u>105</u>

WELL LOCATION:
sec 21 T 26 N R 1 E
S W
6 miles S. E of Lambert
(distance) (direction) (nearest town)

WELL PURPOSE: Industrial
(home, irrigation, municipal, industrial)

- WELL COMPLETION DATA:
- (1) diameter (inches) 6"
 - (2) total depth (feet) 105
 - (3) static water level (feet) 14 below top of ground.
 - (4) casing Steel pipe 6.5
(material) (depth)
6" if telescope see back.
(size)
 - (5) screen 40 65
(length) (depth to top)
6" Down Screen
(size) (material)
 - (6) pump 3/4 HP 65 GPM
(HP) (yield gpm)
Electric
(type power)
 - (7) electric log no
(yes or no)

(organization running log)
 - (8) how well bottom plugged Wedded

CODED


OCT 14 1970

MISS. BD. OF
WATER COMM.

DRILLERS REMARKS:

If well telescopes please sketch and show depths.

GROUND LEVEL

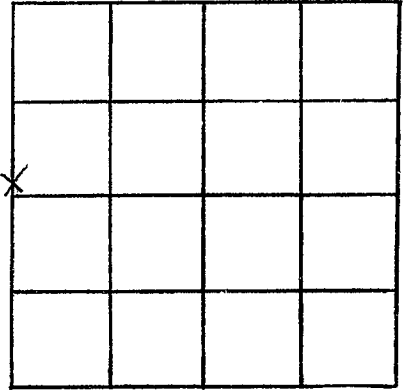

SECTION 21

Please indicate well location X.

ADDITIONAL INFORMATION

If more than one screen, show locations of each on sketch.