

QUITMAN
M28
9-30-70

MISSISSIPPI
BOARD OF WATER COMMISSIONERS
416 North State Street
Jackson, Mississippi 39201

CODED

WATER WELL DRILLERS LOG

9-30-70 19 Pike County Farmers Quitman
date well completed firm name county well located


LANDOWNER:	description of formations encountered	from	to
W. A. Crawford	Top soil		14
Lambert, Miss (mailing address)	Fine Sand	14	40
WELL LOCATION:	Med Sand	40	67
sec <u>29</u> T <u>26</u> N R <u>1</u> E <u>8</u> miles <u>S.E.</u> of <u>Lambert</u> (distance) (direction) (nearest town)	Co. Sands Gravel	47	116
WELL PURPOSE: <u>Irrigation</u> (home, irrigation, municipal, industrial)	Clays & White Sand	116	130
WELL COMPLETION DATA:	CODED		
(1) diameter (inches) <u>6"</u>			
(2) total depth (feet) <u>120</u>			
(3) static water level (feet) <u>14</u> below above top of ground.			
(4) casing <u>Steel</u> , <u>72</u> , (material) (depth)			
<u>6</u> if telescope see back. (size)			
(5) screen <u>48</u> , <u>72</u> (length) (depth to top)			
<u>6</u> , <u>Duro</u> (size) (material)			
(6) pump <u>2 1/2</u> , <u>1400</u> (HP) (yield gpm)			
<u>Tractor</u> (type power)			
(7) electric log <u>no</u> (yes or no)			
(organization running log)			
(8) how well bottom plugged <u>Walled</u>			
DRILLERS REMARKS:			

OCT 14 1970

MISC. BD. 05
WATER COMM.

If well telescopes please sketch and show depths.

GROUND LEVEL

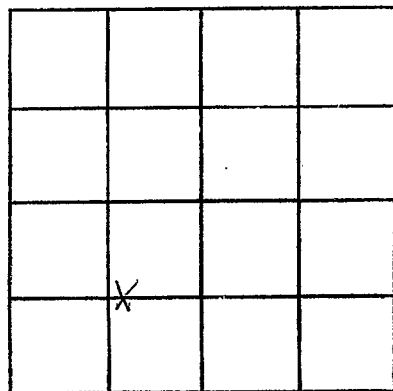

SECTION 29

Please indicate well location X.

ADDITIONAL INFORMATION

If more than one screen,
show locations of each on sketch.