

M29

2-1-63

WATER WELL DRILLERS LOG

CODED

Date: 2-1, 1963, Driller: J B CAIN County Female
 (Name)

(1) Owner of Land	Description & Color of Materials Sand, Clay, Red Clay, Shell, etc.	Thick- ness Feet	Depth Feet
(Name) <u>Charley Austin</u> (Address) <u>Rout 2 Lombert Miss</u>	Clay	0	20
	Sand	20	120
(2) Location:	Blue Clay	120	200
_____ 1/4, _____ 1/4, Sec. <u>22</u> T. <u>27</u> R. <u>12</u>	Sand	200	320
<u>9</u> miles <u>South</u> of <u>Crowder</u>	Blue cl	320	430
(distance).	Sand	430	486
(3) Topography:			
(Hilly)			
(Flat)			
(Level)			
(4) Purpose of Well:			
<u>Home + FARM</u> (Domestic Irrigation Municipal, Industrial, Other)			

Information upon completion of well:

- (1) Diameter 2 inches.
- (2) Total Depth 486 feet.
- (3) Water Level Artesian feet below top of ground.
- (4) Cased to 423, Size 2 1/2
- (5) Screen: Size Open Length _____
- (6) Were any formations sealed against pollution?
 _____ yes, _____ no.


If YES depth of formation _____

Why _____

Drillers Remarks: _____

Coded

CODED

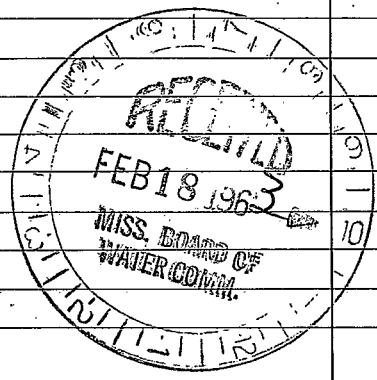

(Use Back Side)

Well No.

Handwritten text, possibly a signature or name, located in the upper left corner.

Handwritten text, possibly a signature or name, located in the lower left quadrant.