

QUITMAN
M 30
11-28-62

WATER WELL DRILLERS LOG

CODED


Date: 11 28, 1962, Driller: J B Cain County Wola

(Name)

| (1) Owner of Land: | Description & Color of Materials Sand, Clay, Red Clay, Shell, etc. | Thick- ness Feet | Depth Feet |
|--|---|------------------------|---------------|
| <u>Jes Miller</u> (Name) <u>Crowder Miss</u> (Address) | <u>Sand</u> | <u>0</u> | <u>150</u> |
| | <u>Blue Clay</u> | <u>150</u> | <u>300</u> |
| | <u>Sand</u> | <u>300</u> | <u>400</u> |
| (2) Location: <u>1/4</u> , <u>1/4</u> , Sec. <u>15</u> <u>T26R1E</u> , <u>5</u> miles <u>South</u> of <u>Crowder</u> (distance) (direction) (Nearest Town) | <u>Blue Clay</u> | <u>400</u> | <u>510</u> |
| | <u>Sand</u> | <u>510</u> | <u>553</u> |
| (3) Topography: <input checked="" type="checkbox"/> (Level) (Hilly) (Flat) | | | |
| (4) Purpose of Well: <u>Home</u> (Domestic Irrigation Municipal, Industrial, Other) | | | |
| Information upon completion of well: | | | |
| (1) Diameter <u>2</u> inches. | | | |
| (2) Total Depth <u>553</u> feet. | | | |
| (3) Water Level <u>Flowing</u> ^{20 gal. minute} feet below top of ground. | | | |
| (4) Cased to <u>504</u> , Size <u>Open</u> | | | |
| (5) Screen: Size <u>NO</u> , Length <u>NO</u> | | | |
| (6) Were any formations sealed against pollution? <u>no</u> | | | |
| If YES depth of formation _____ | | | |
| Why _____ | | | |
| Drillers Remarks: _____ | | | |
| _____ | | | |
| _____ | | | |
| _____ | | | |

Handwritten scribble

CODED

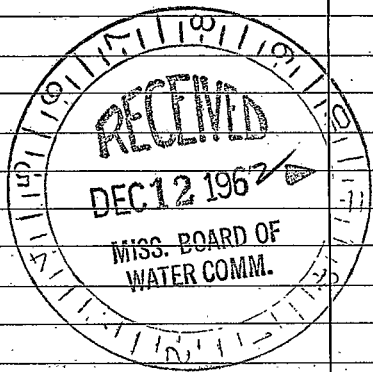

(Use Back Side)

Well No.

