

Quitman
M34
2-10-74

MISSISSIPPI
BOARD OF WATER COMMISSIONERS
416 North State Street
Jackson, Mississippi 39201

CODED

WATER WELL DRILLERS LOG

Feb 10 1974 Bob Cas Quitman
date well completed firm name county well located
(Big Stream)

LANDOWNER: Arthur Whitwell

Description of formations encountered

	from	to
clay	0	10
sand	10	50

(mailing address)


WELL LOCATION:
sec. 17 T 26 N R 1 E
8 miles S-W of Rowden
(distance) (direction) (nearest town)

WELL PURPOSE: Municipal
(home, irrigation, municipal, industrial)

WELL COMPLETION DATA:

- (1) diameter (inches) 4"
- (2) total depth (feet) 30
- (3) static water level (feet) 10 below above top of ground.
- (4) casing PLASTIC 50
(material) (depth)
(size) If telescope see back.
- (5) screen 10' 40
(length) (depth to top)
(size) (material)
- (6) pump 1 35
(HP) (yield gpm)
Electric
(type power)
- (7) electric log no
(yes or no)
(organization running log)
- (8) how well bottom plugged Plug

CODED

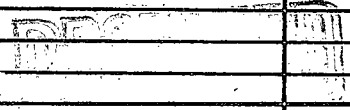


MAR 26 1974

DRILLERS REMARKS:

If well telescopes please sketch and show depths.

GROUND LEVEL

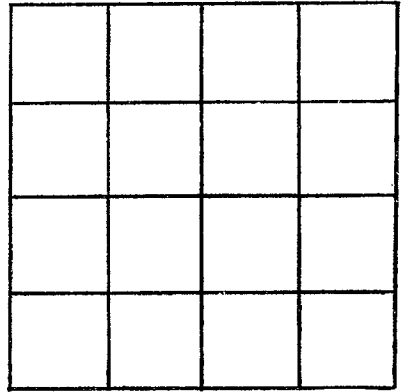

SECTION _____

Please indicate well location X.

ADDITIONAL INFORMATION

If more than one screen,
show locations of each on sketch.