

MISSISSIPPI DEPARTMENT OF LAND AND WATER RESOURCES

Bureau of Land and Water Resources

Southport Mall

P.O. Box 10331

Jackson, Mississippi 39209

WATER WELL DRILLERS LOG

#2  
CODED

Quitman  
M36  
5-18-81

5-18 1981 Edgewell, Inc firm name

Quitman  
FAVOTA county well located

E ANDOWNER Ray Turner

description of formations encountered	from	to
<u>Sand</u>	<u>13</u>	<u>23</u>
<u>Sand</u>	<u>23</u>	<u>33</u>
<u>Sand &amp; gravel</u>	<u>33</u>	<u>43</u>
<u>Sand &amp; gravel</u>	<u>43</u>	<u>53</u>
<u>gravel</u>	<u>53</u>	<u>63</u>
<u>gravel</u>	<u>63</u>	<u>73</u>
<u>Sand &amp; gravel</u>	<u>73</u>	<u>83</u>
<u>gravel</u>	<u>83</u>	<u>93</u>
<u>gravel</u>	<u>93</u>	<u>103</u>
<u>gravel</u>	<u>103</u>	<u>110</u>

Crowder Ms  
(mailing address)


WELL LOCATION:  
Sec. 25 T. 26 N. R. 1 E  
S. 5 miles S. of Crowder  
(distance) (direction) (nearest town)


WELL PURPOSE:  
(home, irrigation, municipal, industrial)

WELL COMPLETION DATA:

- (1) diameter (inches) 16
- (2) total depth (feet) 110
- (3) static water level (feet) 44 below top of ground
- (4) casing Steel (material) (depth)
- 16 (size) If telescopic see back.
- (5) screen 40 (length) (depth to top)
- 16 (size) (material)
- (6) pump (type) (yield gpm)
- Diesel (type power)
- (7) electric log NO (yes or no)
- (organization running log)
- (8) how well bottom plugged Plate

DRILLERS REMARKS:

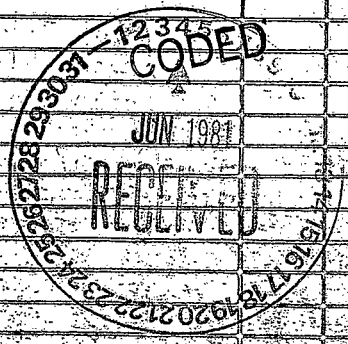

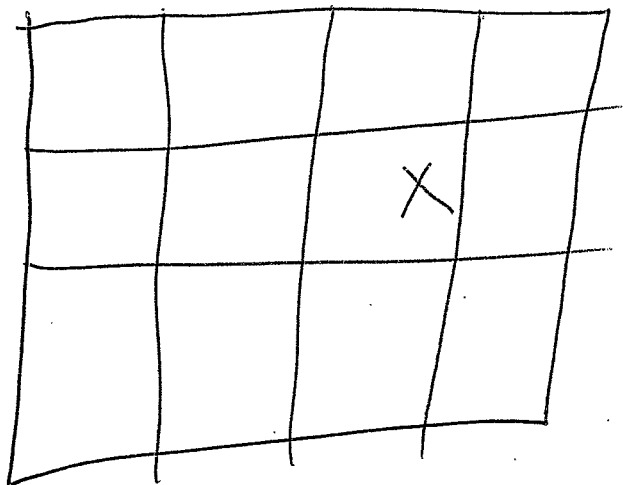

see 25