

MISSISSIPPI DEPARTMENT OF LAND AND WATER RESOURCES

Bureau of Land and Water Resources

Southport Mall

P.O. Box 10631

Jackson, Mississippi 39209

WATER WELL DRILLERS LOG

CODED

Quithran

M37

5-20-81

5-20-81

Ryer Well Dring & Sew

Quithran  
ATA

date well completed

firm name

county well located

LANDOWNER

Ray Turner

description of formations encountered

from to

Crowder Ms

(mailing address)

soil	13	23
soil	23	33
soil	33	43
sand gravel	43	53
sand gravel	53	63
gravel	63	73
sand & gravel	73	83
gravel	83	93
clay	93	103
sand & gravel	103	108

WELL LOCATION:

sec 25 T 26 S R 10 W

5 miles south of Crowder

(distance) (direction) (nearest town)


WELL PURPOSE:

(home, irrigation, municipal, industrial)


WELL COMPLETION DATA:

- (1) diameter (inches) 16
- (2) total depth (feet) 108
- (3) static water level (feet) 4 below top of ground
- (4) casing (material) Steel (depth)
- 16 (size) If telescope see back.
- (5) screen 40 (length) (depth to top)
- 16 (size) (material)
- (6) pump Diesel (HP) (yield gpm)
- (type power)
- (7) electric log NO (yes or no)
- (organization running log)
- (8) how well bottom plugged

CODED

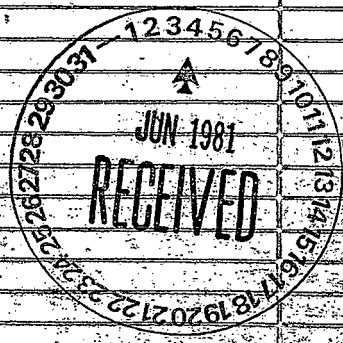

DRILLERS REMARKS

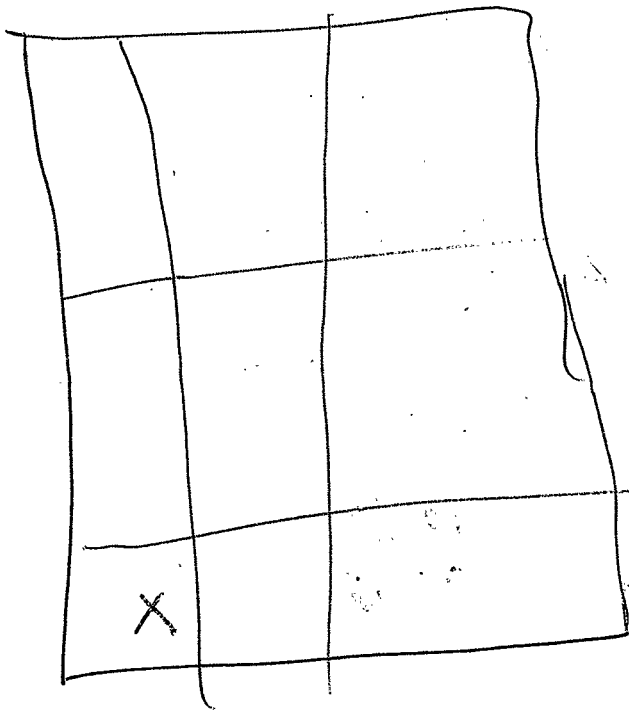

sec 25