

QUITMAN  
M 39  
6-16-81  
GW 3107

MISSISSIPPI DEPARTMENT OF NATURAL RESOURCES  
Bureau of Land and Water Resources  
Southport Mall  
P.O. Box 10631  
Jackson, Mississippi 39209  
WATER WELL DRILLERS LOG

CODED

6-16-1981 date well completed  
Dyer Well Drilling firm name  
Quitman county well located

LANDOWNER:  
Noel Wilborn  
Lumbert, MS.  
(mailing address)

description of formations encountered	from	to
Clay	0	14
fine sand	14	34
Sand & gravel	34	113

WELL LOCATION:  
sec. 3 T 26 N R 10 E  
S W  
3 miles SW of Crowder  
(distance) (direction) (nearest town)

WELL PURPOSE:  
(home, irrigation, municipal, industrial)

CODED

WELL COMPLETION DATA:

(1) diameter (inches) 16

(2) total depth (feet) 113

(3) static water level (feet) 21' below top of ground.


(4) casing Steel, 113' (material) (depth)  
16" (size) if telescope see back.

(5) screen 40' 73' (length) (depth to top)  
16" (size) Steel (material)

(6) pump 60 3000 (HP) (yield gpm)  
Diesel (type power)

(7) electric log (yes or no)  
(organization running log)

(8) how well bottom plugged plate

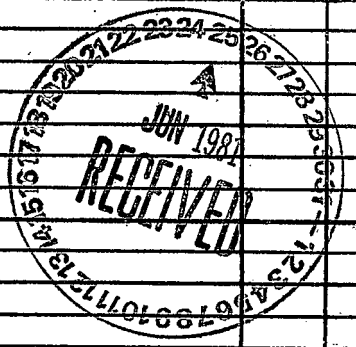

DRILLERS REMARKS:

