

QUITMAN
M 40
6-17-81
GW3108

MISSISSIPPI DEPARTMENT OF NATURAL RESOURCES
 Bureau of Land and Water Resources
 Southport Mall
 P.O. Box 10631
 Jackson, Mississippi 39209
WATER WELL DRILLERS LOG

CODED

6-17-81 date well completed Dyes Well & Frigerton firm name Quitman county well located

LANDOWNER:
Noel Wilburn
Lambert, MS.
 (mailing address)

description of formations encountered	from	to
clay	0	18
fine sand	18	42
sand & gravel	42	106
clay	106	110

WELL LOCATION:
 sec. 3 T 26 N S R 10 E W
3 miles SW of Crowder
 (distance) (direction) (nearest town)

CODED

WELL PURPOSE:
 (home, irrigation, municipal, industrial)

WELL COMPLETION DATA:

(1) diameter (inches) 16

(2) total depth (feet) 106'

(3) static water level (feet) 21' below above top of ground.

(4) casing Steel, 106'
 (material) (depth)
16" if telescope see back.
 (size)


(5) screen 40', 66'
 (length) (depth to top)
16", Steel
 (size) (material)

(6) pump 60, 3000
 (HP) (yield gpm)
Diesel
 (type power)

(7) electric log _____
 (yes or no)

_____ (organization running log)


(8) how well bottom plugged plate

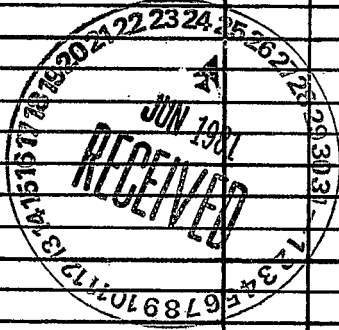

DRILLERS REMARKS:

If well telescopes please sketch and show depths.

GROUND LEVEL

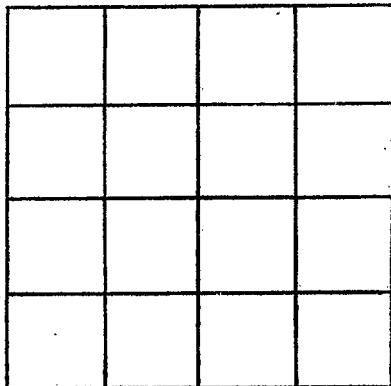

SECTION _____

Please indicate well location X.

ADDITIONAL INFORMATION

If more than one screen,
show locations of each on sketch.