

MISSISSIPPI DEPARTMENT OF NATURAL RESOURCES

Bureau of Land and Water Resources

Southport Mall

P.O. Box 1058

Jackson, Mississippi 39209

WATER WELL DRILLERS LOG

**CODED**

Quitman  
M 41  
7-18-81

7/18/81 date well completed  
Dyersville & Sons firm name  
Quitman county well located

LANDOWNER W.A. Crawford

description of formations encountered	from	to
Clay	D 18	
Fine Sand	18	24
Sand & Gravel	28	86
Sand	86	92
Sand & Gravel	92	100

Lambert Ms. (mailing address)

WELL LOCATION:  
sec. 7 T. 26 N. R. 10 E  
S  
6 miles SE of Lambert  
(distance) (direction) (nearest town)

WELL PURPOSE:  
(home, irrigation, municipal, industrial)

WELL COMPLETION DATA:


- (1) diameter (inches) 16
- (2) total depth (feet) 100
- (3) static water level (feet) 21 below above top of ground.
- (4) casing Steel 6.01  
(material) (depth)  
16 if telescope see back.  
(size)
- (5) screen 401 60'  
(length) (depth to top)  
14 Steel  
(size) (material)
- (6) pump 60 3000  
(HP) (yield gpm)  
Electric  
(type power)
- (7) electric log NO  
(yes or no)

(organization running log)

(8) how well bottom plugged Plate


DRILLERS REMARKS:

**CODED**

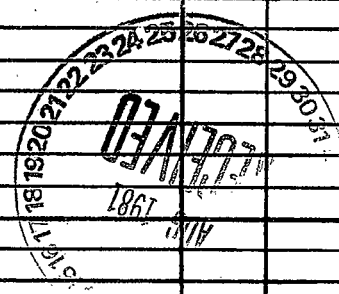

If well telescopes please sketch and show depths.

GROUND LEVEL

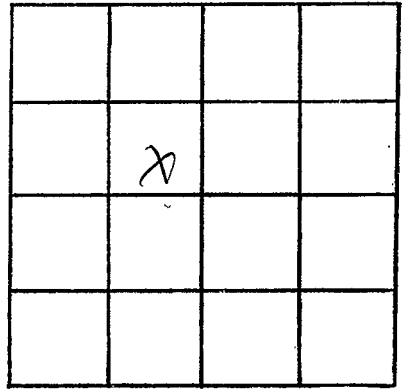

SECTION 2

Please indicate well location X.

ADDITIONAL INFORMATION

If more than one screen,  
show locations of each on sketch.