State Well Report For Office Use Only: County: Quitman Part 1 Mississippi Department of Environmental Quality Aquifer:
Permit # $GW 4/2.79$ Mississippi Department of Environmental Quality Aquiter M_19
Irrigation Equipment BO Boy 10631 Well #: //- 41
Jackson MS 39289-0631
Date drilling completed: $8-4-0.6$ (601)961-5210 (601)354-6938 (fax) E-log #:
State Law requires that this report be prepared by the driller in detail and filed with the Department within 30 days of completion of drilling of the well.
Well Owner Information Well Location
Owner Name Mike Green Latitude: 34 05 1.4.6. Longitude: 90 014 28.
Mailing Address: <u>109 Overbrook Hill</u> Method of Lat/Long (circle one): Conventional Survey,
USGS quad, Hand-held GPS, Survey-grade GPS
NW 1/2 NW 1/2 Sec 31 Twn 26N Rng 1E
Ridgeland MS 39157 City State Zip Code Distance Direction Nearest Town
<u>7 Miles East of Vance</u>
Telephone No. (
Well Data Wildlife
Purpose of Well (circle one) Home Industrial Public Supply rrigation Fish Culture Other.
Date well drilling started: $8-4-06$ Date well drilling completed: $8-4-06$
If flowing, method of flow regulation: Valve Other (describe)
Static Water Level: feet above or pelow (circle one) land surface Date measured: 8-16-06
Method of Measurement (circle one) teel tape electric tape air line other:
Hole depth: <u>113</u> Weil depth: <u>113</u> Weil grouted to a depth of <u>10</u> feet
Type of grout (circle one): Cement Bentonite Mix
Casing length: 73 feet Casing diameter: 16 inches Type of casing: PVC Sch. 40
Screen length: <u>40</u> feet Screen diameter: <u>16</u> inches Type of screen: <u>PVC Sch. 40</u>
Screen slot size: <u>.050</u> inches Setting depth: From 74 feet to 113 feet
Type of completion (circle all applicable): (Gravel packed Underreamed Telescoped Open hole Natural Development
Other (describe):
Top of lap pipe or reduction in casing:fcet. If telescoped or more than one screen, describe on back of page Logs run (circle all applicable): No log run Electric Gamma Ray Density Sonic Neutron Other:
Name of organization running log(s): I certify that the well was drilled, constructed, and completed in accordance with all applicable requirements of the Mississip
Department of Environmental Quality and/or the Mississippi Department of Health regulations and state laws.
Irrigation Equipment Inc. Patrick M. Chism 0695

۰.

.


AUG 2 + 2006 BY: OLW P. If well telescopes please sketch below and show depths.

Ground Level

Description of Formations Encountered	From To
Clay	0 15
Fino Cand	16 25
Fine Sand/gravel Med. Sand/gravel	26 45
Med. Sand/gravel	46110
Clay	111113
	
· · · · · · · · · · · · · · · · · · ·	<u> </u>
	
	+
	┿╍╌┼╍╌┥
	╉╌╌╂╼╌┨
	╶┼──┤──┤
	╺╀╧╾╌╂╾╾╌┨

M- . .

If more than one screen, show location of each on sketch

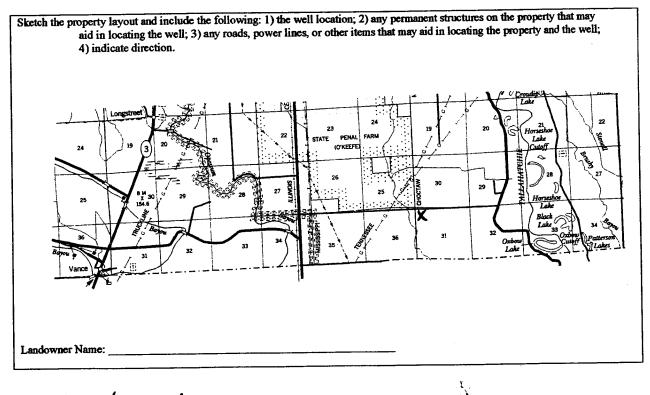

a

Signature of Water Well Contractor

		STATE W	ELL REPORT		
County: Quitn			Part 2 's Completion Report	For Office Use Only:	٦
Permit #: GUL		Mississippi Departme	ent of Environmental Quality	Aquifer:	
Irrigatic	on Equipmer	it Office of Land	and Water Resources	Well#: M-49	-
Date completed:	8-4-06	Jackson,	P.O. Box 10631 Jackson, MS 39289-0631 (601)961-5210		-
Copy information fre			i54-6938 (fax)	Elevation:	-
This part of the re	port must be comple	 ted by a licensed water wel	l contractor or a licensed pump i	ustaller. A copy of Part 1 of the	;
report must be atta	iched and both parts Well Owner Inform	filed with the Department	at the above address within 30 d	lays of well completion.	
Mal				I Location	
Owner Name: Mil			Latitude:	_Longitude:	-
109 Overbrook Hill Mailing Address:		Method of Lat/Long (check o	nc): Conventional Survey,		
			USGS quad Hand-held	GPS, Survey-grade GPS	
					-
Ri C	Lageland M Xity Stat	<u>1S 39157</u> zip Code	<u>NW 14 NW 14 Sec 31</u>	TZONRIE	
	-	• • • • • •	Distance Direction	Nearest Town	
Telephone No. ()		7 Miles East	f Vance	
	Римр Турс	· · · · · · · · · · · · · · · · · · ·	Pa	wer Type	
	Circle one			ircle one	
Air Lift	Jet	Submersible	Diesel Engine Gasoli	ne Engine Natural Gas	3
Bucket	Piston	Turbine	Electric Motor Hand	Tractor PTO)
Centrifugal	Rotary	Flowing Well	Windmill Other	(specify):	
Other (specify):			Horse Power Rating of Motor	60	
Date Pump Installed	<u>8–16–06</u>		Setting Depth:	70 feet	
Rated Pump Canacit	2500-30) 0 0 Gallons Per Minute	Number of Stages:1		
Tumo I ump Capaca			Number of Stages.		
	Pump Test Da	ta	Method of M	casuring Water Level	
Data Well Trate 1	-			Aircle one	
Date Well Tested:			Air Line Electric Me	asuring Line Steel Tape	
Static Water Level (A):F	ect Below Land Surface		• •	
Pumping Water Lev	el (B):Fe	et Below Land Surface	Other (specify):		-
Drawdown [(B) (A	()]:Fo	cet Below Land Surface	For flowing well, measured s	hut in head:fee	t
Test Pumping Rate:		Gallons Per Minute	Well yielded	GPM with a drawdown of	
Duration of Pump To	est (minimum 4 hou	rs): bours		hours of pumpin	~
	~~~ (1111111111111111111111111111111111	HOUIS		"non 2 01 bauluti	6
				RE(	ĴE
			Λ		
I HEREBY CERTIF	Y that the above sta	tements are true to the best	of my knowledge.		6.2
	<b>Y that the above sta</b> ck M. Chisn		of my knowledge.	Autor Autor	G 2

.

* . . * .

· •