

MISSISSIPPI DEPARTMENT OF NATURAL RESOURCES

Bureau of Land and Water Resources

Southport Mall

P.O. Box 10631

CODED

Jackson, Mississippi 39209

WATER WELL DRILLERS LOG

QUITMAN

764
~~COAHOMA~~ QUITMAN
 3-18-85
 GW02254

3-18 1985

Powell Irr

~~COAHOMA~~

date well completed

firm name

county well located

LANDOWNER:

Bobby Shields

Crowder, MS
 (mailing address)

description of formations encountered

from to

CLAY	0	20
FINE SAND	20	30
FINE & COARSE SAND	30	40
COARSE SAND	40	80
HEAVY GRAVEL	80	93

WELL LOCATION:

Section 26 N, Range 1 E
 1 miles SO of Crowder
 (distance) (direction) (nearest town)

WELL PURPOSE: IRrigation
 (home, irrigation, municipal, industrial)

WELL COMPLETION DATA:

- (1) diameter (inches) 16
- (2) total depth (feet) 93
- (3) static water level (feet) 4 below above top of ground.
- (4) casing steel 53
 (material) (depth)
16 if telescope see back.
 (size)
- (5) screen 40 53
 (length) (depth to top)
16 steel
 (size) (material)
- (6) pump 40 2000
 (HP) (yield gpm)
Electric
 (type power)
- (7) electric log NO
 (yes or no)

(organization running log)

- (8) how well bottom plugged Steel
PLATE

DRILLERS REMARKS:


CODED

RECEIVED
 APR 22 1985

Department of Natural Resources
 Bureau of Land & Water Resources

If well telescopes please sketch and show depths.

GROUND LEVEL

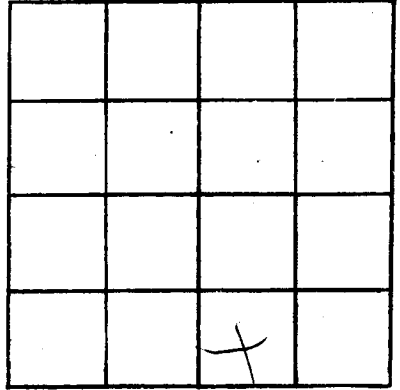

SECTION 361

Please indicate well location X.

ADDITIONAL INFORMATION

If more than one screen, show locations of each on sketch.