

Quitman

M 2000

3/31/79

3-31

date well completed

MISSISSIPPI BOARD OF WATER COMMISSIONERS
416 North State Street
Jackson, Mississippi 39201

WATER WELL DRILLERS LOG

1979 Five Co. Farm Quitman
firm name county well located

LANDOWNER: B.E. PINION

LAMBERT MISS

(mailing address)

WELL LOCATION:

sec 14 T 26 N R 1 E
S W
7 miles SOUTH of LAMBERT
(distance) (direction) (nearest town)

WELL PURPOSE:

(home, irrigation, municipal, industrial)

WELL COMPLETION DATA:

- (1) diameter (inches) 2"
- (2) total depth (feet) 75
- (3) static water level (feet) 9 below above top of ground.
- (4) casing Galv. 63
(material) (depth)
 If telescope see back.
(size)
- (5) screen 12 63
(length) (depth to top)
2" STAINLESS STEEL
(size) (material)
- (6) pump 1.5 22
(HP) (yield gpm)
Electric
(type power)
- (7) electric log NO
(yes or no)

(organization running log)

(8) how well bottom plugged Point

DRILLERS REMARKS:

description of formations encountered

from

to

| | | |
|--------------------------|-----------|-----------|
| <u>top clay</u> | <u>1</u> | <u>8</u> |
| <u>fine sand</u> | <u>8</u> | <u>14</u> |
| <u>coarse sand</u> | <u>14</u> | <u>39</u> |
| <u>sand & gravel</u> | <u>39</u> | <u>75</u> |


Miss. Board of Water Comm.

APR 9 1979

RECEIVED

If well telescopes please sketch and show depths.

GROUND LEVEL

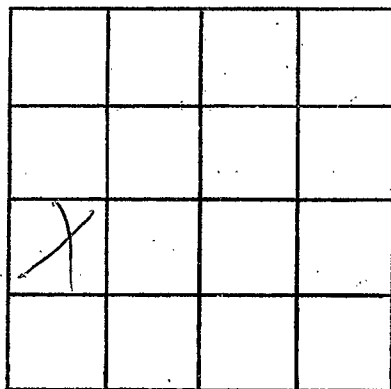

SECTION 14

Please indicate well location X.

ADDITIONAL INFORMATION

If more than one screen,
show locations of each on sketch.