

**MISSISSIPPI DEPARTMENT OF ENVIRONMENTAL QUALITY**

Office of Land and Water Resources

P. O. Box 10631  
Jackson, MS 39289-0631

**WATER WELL DRILLERS LOG**

COUNTY WELL LOCATED <i>DeWitt</i>	
WELL NUMBER <i>M</i>	CODED
DATE WELL COMPLETED <i>2004</i> 5-23-94	

PERMIT NUMBER <i>GW14813</i>
NAME OF DRILLING FIRM <i>TIVE CO</i>

NAME & MAILING ADDRESS OF LANDOWNER <i>Sam C. Gary</i>			
<i>5178 Wheelis</i>			
<i>Memphis, TN</i>			
WELL LOCATION:	SEC	TOWNSHIP	RANGE
	<i>22</i>	<i>26</i>	<i>N 1 E</i> <i>S W</i>
DISTANCE	DIRECTION	NEAREST TOWN	
<i>5 1/2</i> Miles	<i>SW</i>	<i>Crowder</i>	
OTHER LANDMARK <i>On Old Chrisholm Rd</i>			
WELL PURPOSE: Home, Irrigation, Municipal, Industrial, Fish Pond, etc. <i>Irrigation</i>			

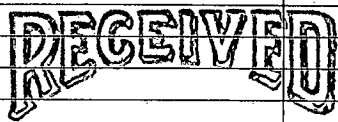
<b>PUMP DATA</b>		
PUMP TYPE (Circle One): Submersible, <u>Turbine</u> Jet Flowing Well, Other (Describe) _____		
ELECTRIC (Circle One): Electric, Tractor, <u>Diesel</u> Gasoline, Butane, Other (Describe) _____ H/P _____		
Pump Capacity (GPM) <i>3000</i>	No. of Stages <i>1</i>	Setting Depth <i>50</i> FT.
PUMP TEST		
Well yielded _____ GPM with a drawdown of _____ ft. after _____ hours of pumping		

<b>WELL DATA</b>		
Well Depth <i>94</i>	Casing Diameter (In.) <i>16</i>	Casing Length (Ft.) <i>54</i>
Type of Casing <i>Steel</i>	Hole Depth <i>94</i>	Depth to Static Water Level
TYPE OF COMPLETION: (Circle One or More): Gravel Packed, Underreamed, Telescoped, Natural Development, Open Hole, Other (Describe) _____		
WELL GROUTED TO A DEPTH OF _____ FEET Type Grout (circle one): Cement, Bentonite, or Mix		

<b>LOG DATA</b>	
TYPE OF LOG RUN (Circle One): Electric, Gamma Ray, Density, Sonic, Neutron, Other (Describe) _____	
Name of Organization Running Log	

<b>SCREEN DATA</b>		
Diameter - Inches <i>16</i>	Length - Feet <i>40</i>	Slot Size - Inches <i>.060</i>
Screen Type <i>Steel</i>	Depth to Bottom - Feet <i>94</i>	

<b>GEOLOGIC DATA (Office Use Only)</b>			
Surface Elev.	Geologic Unit	Unit Thickness	Depth to Top
Subs. SWL	Date	Analysis	Aquifer Test
Driller's Remarks			
Top of Lap Pipe or Reduction in Casing			
FEET		IF TELESCOPED OR MORE THAN ONE SCREEN: USE BACK PAGE	

DESCRIPTION OF FORMATIONS ENCOUNTERED	FROM	TO	FORMATIONS (Continued)	FROM	TO
Clay	0	15	 <b>JUL 18 1994</b> Dept. of Environmental Quality Office of Land & Water Resources		
Fine Sand & Gravel.	15	25			
Medium Sand & Gravel.	25	45			
Coarse Sand & Gravel.	45	65			
Medium Sand & Gravel	65	94			
			IF MORE SPACE IS NEEDED, USE BACK		

If well telescopes please  
sketch and show depths.

GROUND LEVEL


SECTION \_\_\_\_\_

Please indicate well location X.

ADDITIONAL INFORMATION

If more than one screen,  
show location of each on sketch.