

QUITMAN MISSISSIPPI BOARD OF WATER COMMISSIONERS

M 2010

1-1-65

WATER WELL DRILLERS LOG

Date: 1-1, 1965, Driller: J B Cain County Parola

(Name)


(1) Owner of Land	Description & Color of Materials Sand, Clay, Red Clay, Shell, etc.	Thick- ness Feet	Depth Feet
<u>J B Ratenbury</u> (Name)	<u>Sand</u>	<u>0</u>	<u>150</u>
<u>Crowder Miss</u> (Address)	<u>Blue Cl</u>	<u>150</u>	<u>205</u>
	<u>Sand</u>	<u>205</u>	<u>300</u>
(2) Location: <u>1/4</u> , <u>1/4</u> , Sec. <u> </u> T <u> </u> R <u> </u>	<u>Hard Blue Cl</u>	<u>300</u>	<u>400</u>
<u>2</u> miles <u>SS</u> of <u>Crowder</u> (distance) (direction) (Nearest Town)	<u>Sand</u>	<u>400</u>	<u>550</u>
(3) Topography: <u> </u> (Hilly) (Flat) (Level)			
(4) Purpose of Well: <u>Home</u> (Domestic Irrigation Municipal, Industrial, Other)			

Information upon completion of well:

- (1) Diameter 2 inches.
- (2) Total Depth 550 feet.
- (3) Water Level Flow feet below top of ground.
- (4) Cased to 400, Size 2
- (5) Screen: Size None, Length
- (6) Were any formations sealed against pollution?
 yes, no.

If YES depth of formation
Why

Drillers Remarks:

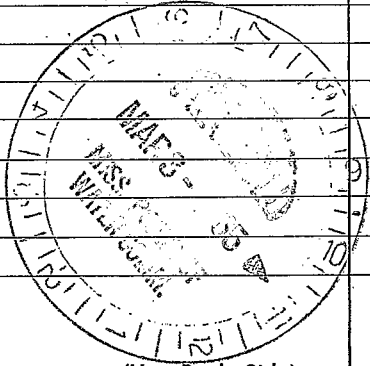

(Use Back Side)

Well No.

