

M 2011

1-2-65

WATER WELL DRILLERS LOG

Date: 1-2, 1965, Driller: J B Cain County Pondera  
 (Name)

(1) Owner of Land:	Description & Color of Materials Sand, Clay, Red Clay, Shell, etc.	Thick- ness Feet	Depth Feet
<u>Nelanda Jentry</u> (Name) <u>Crowder miss</u> (Address)	<u>Sand</u> <u>Blue cl</u> <u>land</u>	<u>0</u> <u>208</u> <u>390</u>	<u>208</u> <u>390</u> <u>450</u>
(2) Location: <u>1/4</u> , <u>1/4</u> , Sec. <u>   </u> T <u>   </u> R <u>   </u>			
<u>8</u> miles <u>S</u> of <u>Crowder</u> (distance) (direction) (Nearest Town)			
(3) Topography: (Hilly) (Flat) (Level)			
(4) Purpose of Well: <u>Home</u> (Domestic Irrigation Municipal, Industrial, Other)			

Information upon completion of well:

(1) Diameter 2 inches.

(2) Total Depth 450 feet.

(3) Water Level Flow feet below top of ground.

(4) Cased to 400, Size    


(5) Screen: Size None, Length    

(6) Were any formations sealed against pollution?  
    yes,     no.

If YES depth of formation    

Why    

Drillers Remarks:    

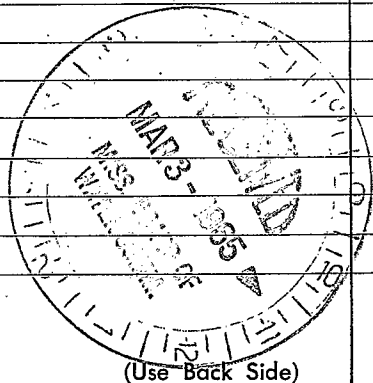

(Use Back Side)

Well No.

