

MISSISSIPPI BOARD OF WATER COMMISSIONERS

WATER WELL DRILLERS LOG

CODED

1965  
CODED

Date: 10-29-1965, Driller: Layne-Central Co. County: Rankin

(Name)

Pearl River Valley Water  
 (1) Owner of Land: Supply District  
 (Name)  
 Jackson, Mississippi  
 (Address)  
 (2) Location: SE 1/4, SE 1/4, Sec. 30 T. 4 R. BN 4E  
 on Hwy 43 at Lake Harbor sub  
 \_\_\_\_\_ miles \_\_\_\_\_ of \_\_\_\_\_  
 (distance) (direction) (Nearest Town)  
 (3) Topography: \_\_\_\_\_  
 (Hilly) (Flat) (Level)  
 (4) Purpose of Well: Municipal  
 (Domestic Irrigation  
 Municipal, Industrial, Other)


Description & Color of Materials Sand, Clay, Red Clay, Shell, etc.	Thick- ness Feet	Depth Feet
top soil	2	2
yellow clay	30	32
white sand	10	42
sand stks clay	68	110
blue clay	20	130
rock	1	131
sandy shale stks sand	139	270
sand stks shale	46	316
shale stks sand	89	407
sandy shale	35	442
sand	10	452
sand stks clay	16	468
sand	32	500
shale stks sand	39	539
rock	1	540
hard shale	70	610

Information upon completion of well:

(1) Diameter 10" inches.  
 (2) Total Depth 502 feet.  
 (3) Water Level 70 feet below top of ground.  
 (4) Cased to 440', Size 10"  
 (5) Screen: Size 6", Length 52' 3".  
 (6) Were any formations sealed against pollution?  
 X yes, \_\_\_\_\_ no.

If YES depth of formation 440'  
 Why \_\_\_\_\_

Drillers Remarks:  
 25 HP  
 300 GPM @ 60#

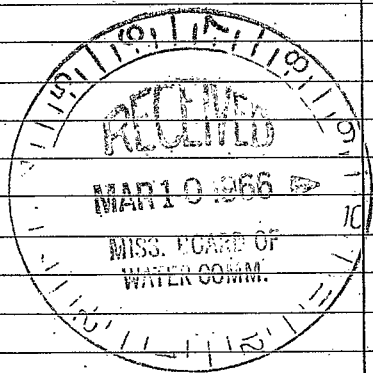

(Use Back Side)

Well No.

(X)