

Rankin
A12
4-67

MISSISSIPPI
BOARD OF WATER COMMISSIONERS
416 North State Street
Jackson, Mississippi 39201

CODED

WATER WELL DRILLERS LOG

April 9 1967 W. H. Butler Rankin
date well completed firm name county well located

LANDOWNER:

description of formations encountered

from

to

Mingo DANDOL
Rt. 3 - Brandon Box
(mailing address) 135

Chalk	1-	135
Rock + Shell	135-	140
Sand + Shell	140-	150
Sand + Chalk	150-	160
Chalk	160-	170
Rock + Chalk	170-	180
Chalk	180-	190
Sand	190-	210

WELL LOCATION:

sec 33 T 2 N R 4 E
S W
1 1/2 miles NW of Sand Hill
(distance) (direction) (nearest town)

WELL PURPOSE: home
(home, irrigation, municipal, industrial)

WELL COMPLETION DATA:

- (1) diameter (inches) 2"
- (2) total depth (feet) 210'
- (3) static water level (feet) 110' ^{below} _{above} top of ground.
- (4) casing galv., 205,
(material) (depth)
2"
(size) If telescope see back.
- (5) screen 5', 205
(length) (depth to top)
2", stainless steel
(size) (material)
- (6) pump 1, 3
(HP) (yield gpm)
Elec
(type power)
- (7) electric log No.
(yes or no)

CODED


(organization running log)

(8) how well bottom plugged 2" Bore hole
wash water

DRILLERS REMARKS:

If well telescopes please sketch and show depths.

GROUND LEVEL

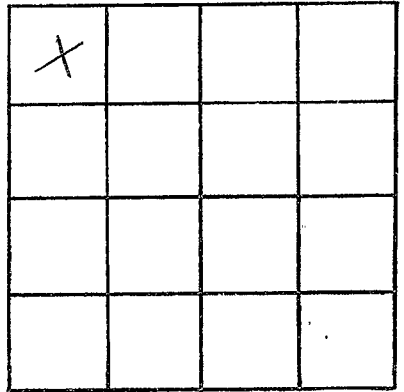

SECTION 33

Please indicate well location X.

ADDITIONAL INFORMATION

If more than one screen, show locations of each on sketch.