

RANKIN
A 15
5-31-72

61
MISSISSIPPI
BOARD OF WATER COMMISSIONERS
 416 North State Street
 Jackson, Mississippi 39201

WATER WELL DRILLERS LOG

CODED

date well completed May 31 1972 firm name Wilkinson Drill Serv. county well located Rankin

LANDOWNER: <u>Tommy Scwindle</u>	description of formations encountered	from	to
<u>R. 3 Box 137 1/2</u>			
<u>Brandon, Miss 39042</u> (mailing address)	<u>Yellow Clay</u>	<u>0</u>	<u>20</u>
	<u>Blue "</u>	<u>20</u>	<u>178</u>
	<u>Sandy Rocky</u>	<u>178</u>	<u>300</u>
	<u>W. Sand</u>	<u>300</u>	<u>525</u>

WELL LOCATION:
 sec. 33 T 8 N 3 R 4 E
 miles _____ of Brandon
 (distance) (direction) (nearest town)

WELL PURPOSE: Home
 (home, irrigation, municipal, industrial)

- WELL COMPLETION DATA:
- diameter (inches) 2
 - total depth (feet) 325
 - static water level (feet) 95 below above top of ground.
 - casing Galv. 325'
 (material) (depth)
 (size) If telescope see back.
 - screen 8 8.8 steel
 (length) (depth to top)
2 (size) (material)
 - pump _____ (HP) _____ (yield gpm)
 (type power)
 - electric log Y
 (yes or no)
 (organization running log)
 - how well bottom plugged B.W.V.

CODED


JUN 20 1972

MISSISSIPPI
 BOARD OF WATER COMMISSIONERS

DRILLERS REMARKS:

If well telescopes please sketch and show depths.

GROUND LEVEL

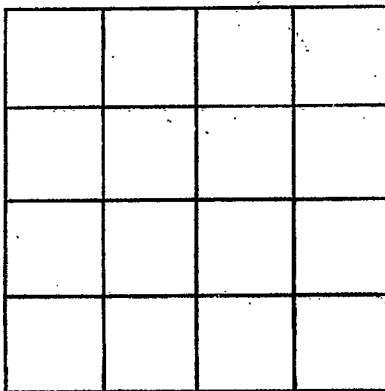

SECTION _____

Please indicate well location X.

ADDITIONAL INFORMATION

If more than one screen,
show locations of each on sketch.