

~~45~~ A17

11-27-64

WATER WELL DRILLERS LOG

CODED

Date: Nov 27, 1964, Driller: M Kay County: Rankin
(Name)

(1) Owner of Land: Phelps
(Name)
Brandon
(Address)

(2) Location: 1/4, 1/4, Sec. 32 T 8 R 4,
2 1/2 miles SE, of 43 Bridge
(distance) (direction) (Nearest Town)

(3) Topography: (Hilly) (Flat) (Level)

(4) Purpose of Well: Home
(Domestic Irrigation, Municipal, Industrial, Other)

Information upon completion of well:

(1) Diameter 2 inches.

(2) Total Depth 47 feet.

(3) Water Level 22 feet below top of ground.


(4) Cased to _____, Size _____

(5) Screen: Size 007, Length 10

(6) Were any formations sealed against pollution?
 _____ yes, no.

Description & -Color of Materials Sand, Clay, Red Clay, Shell, etc.	Thick- ness Feet	Depth Feet
<u>White clay</u>	<u>0</u>	<u>20</u>
<u>Yellow clay</u>	<u>10</u>	<u>20</u>
<u>Blue clay</u>	<u>20</u>	<u>30</u>
<u>med Sand</u>	<u>30</u>	<u>40</u>
<u>med Sand</u>	<u>40</u>	<u>47</u>
<u>Dull test holes</u>		
<u>700 ft east of this well -</u>		
<u>White clay</u>	<u>0</u>	<u>20</u>
<u>Blue clay</u>	<u>20</u>	<u>40</u>
<u>Blue clay</u>	<u>40</u>	<u>60</u>

CODED

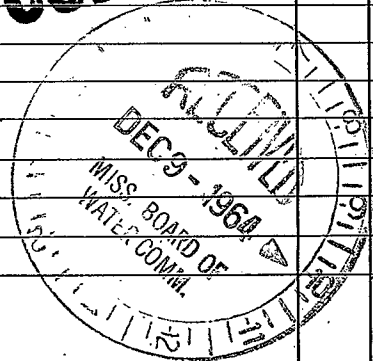

(Use Back Side)

Well No.

Number

11/10/17

11/10/17

0	0
10	10
20	20
30	30
40	40
50	50

White
Yellow
Green
Red
Black

Number
11/10/17

11/10/17

25

25

Number

Blue
Green
Yellow
White
Red
Black

0	0
10	10
20	20
30	30
40	40
50	50

10
20
30

10

100

