

~~EA~~ A 18
6-13-66

WATER WELL DRILLERS LOG

CODED

Date: 6-13, 1966, Driller: J P Thomson County Montgomery

(Name)

(1) Owner of Land: Mr Denson

(Name)

Morton Miss

(Address)

(2) Location: 1/4, 1/4, Sec. 14 T 8 R 4

12 miles N.W., of Morton

(distance)

(direction)

(Nearest Town)

(3) Topography: hilly

(Hilly)

(Flat)

(Level)

(4) Purpose of Well: Domestic

(Domestic Irrigation
Municipal, Industrial, Other)

Description & Color of Materials Sand, Clay, Red Clay, Shell, etc.	Thick- ness Feet	Depth Feet
<u>yellow clay</u>	<u>30</u>	
<u>gray sand</u>	<u>42</u>	
<u>dark mite</u>	<u>30</u>	
<u>Shale</u>	<u>150</u>	
<u>fine black sand</u>	<u>25</u>	
<u>rock</u>	<u>2</u>	
<u>gray water sand</u>	<u>41</u>	
	<u>368</u>	

Information upon completion of well:

(1) Diameter 2 inches.

(2) Total Depth 368 feet.

(3) Water Level 90 feet below top of ground.

(4) Cased to 321, Size 10 1/2

(5) Screen: Size 1 1/4, Length 130 ft

(6) Were any formations sealed against pollution?


_____ yes, _____ no.

If YES depth of formation _____

Why _____

Drillers Remarks: 800 gal p. hr

CODED

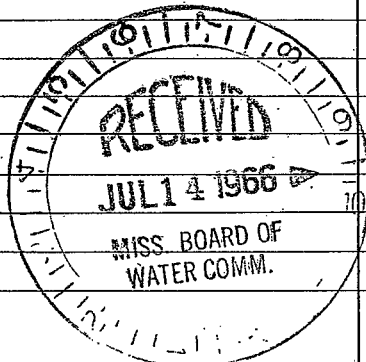

(Use Back Side)

Well No.

1970