

RANKIN

A 19

2-5-73

MISSISSIPPI
 BOARD OF WATER COMMISSIONERS
 416 North State Street
 Jackson, Mississippi 39201

CODED

WATER WELL DRILLERS LOG

Feb 5

1973 W.G. Butler

RANKIN

date well completed

firm name

county well located

LANDOWNER:

Henry CLANTON

Pelzbach, Miss
(mailing address) Rt.

description of formations encountered

from

to

WELL LOCATION:

sec. 24 T 8 N R 4 E
 S W
 3 miles N of Pisgah
 (distance) (direction) (nearest town)

Clay	0	110
shell + sand	110	130
shell-clay-sand	130	140
Clay + sand	140	170
Clay	170	215
sand-clay bicnite	215	225
sand + bicnite	225	235
sand + clay	235	305
sand	305	325

WELL PURPOSE:

HOME (home, irrigation, municipal, industrial)

WELL COMPLETION DATA:

- (1) diameter (inches) 2"
- (2) total depth (feet) 225'
- (3) static water level (feet) 100' ^{below}/_{above} top of ground.
- (4) casing 921' 315' (material) (depth)
2" if telescope see back.
- (5) screen 10' 315' (length) (depth to top)
2" (size) S.S. (material)
- (6) pump 2 1/2 Aircomp. 15 (HP) (yield gpm)
Electric (type power)
- (7) electric log No (yes or no)
- (8) how well bottom plugged 2" BWV.


CODED

DRILLERS REMARKS:

FR 28 1973

If well telescopes please sketch and show depths.

GROUND LEVEL

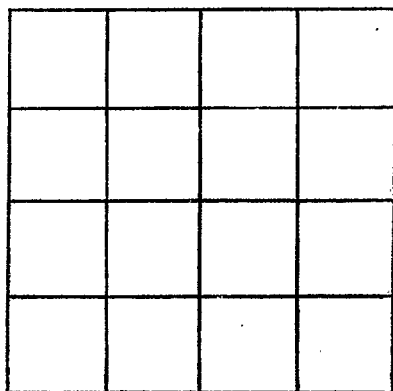

SECTION _____

Please indicate well location X.

ADDITIONAL INFORMATION

If more than one screen,
show locations of each on sketch.