

**RANKIN**  
**A 20**  
**3-6-74**

**MISSISSIPPI**  
**BOARD OF WATER COMMISSIONERS**  
 416 North State Street  
 Jackson, Mississippi 39201 **CODED**

**WATER WELL DRILLERS LOG**

316 1974 Forest Drilling Ser. Rankin  
 date well completed firm name county well located

LANDOWNER:	description of formations encountered	from	to
<u>Neil Hall</u>			
<u>P.O. Box 322, Sand Hill</u> (mailing address)	<u>Blue clay</u>	<u>25</u>	<u>81</u>
	<u>Clay + sts lime rock</u>	<u>81</u>	<u>91</u>
<b>WELL LOCATION:</b> sec. <u>14</u> T. <u>8</u> N. R. <u>4</u> E <u>5</u> miles <u>S.W.</u> of <u>Ludlow</u> (distance) (direction) (nearest town)	<u>Clay + shale</u>	<u>91</u>	<u>102</u>
	<u>Clay, silt + sand</u>	<u>102</u>	<u>163</u>
<b>WELL PURPOSE:</b> (home, irrigation, municipal, industrial)	<u>fine sand + sts clay</u>	<u>163</u>	<u>180</u>
	<u>Clay</u>	<u>180</u>	<u>260</u>
<b>WELL COMPLETION DATA:</b>	<u>fine sand</u>	<u>260</u>	<u>65</u>
	<u>sand + shale</u>	<u>265</u>	<u>347</u>
(1) diameter (inches) <u>2</u>	<u>sand + clay</u>	<u>347</u>	<u>387</u>
	<u>fine sand</u>	<u>387</u>	<u>449</u>
(2) total depth (feet) <u>428</u>	<u>clay</u>	<u>449</u>	<u>490</u>
(3) static water level (feet) <u>103</u> below top of ground.			
(4) casing <u>Galv.</u> , <u>418</u> , (material) (depth)			
<u>2</u> If telescope see back. (size)			
(5) screen <u>10</u> , <u>408</u> (length) (depth to top)			
<u>2</u> , <u>55 #008</u> (size) (material)			
(6) pump <u>3</u> (HP) (yield gpm)			
<u>Electric</u> (type power)			
(7) electric log <u>no</u> (yes or no)			
<u>no</u> (organization running log)			
(8) how well bottom plugged <u>B.W. Valve</u>			


**CODED**

APR 16 1974  
 MISS. Bd. of WATER COMM.

DRILLERS REMARKS:

If well telescopes please sketch and show depths.

GROUND LEVEL

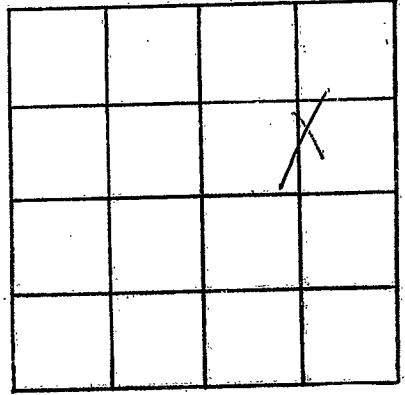

SECTION 14

Please indicate well location X.

ADDITIONAL INFORMATION

Lined area for additional information.

If more than one screen, show locations of each on sketch.