

RANKIN

A

2000

MISSISSIPPI
 BOARD OF WATER COMMISSIONERS
 416 North State Street
 Jackson, Mississippi 39201

WATER WELL DRILLERS LOG

Dec. 1978

THOMAS

Rankin

LANDOWNER: Woods ^{James} ~~Hurtig~~ Club
Sand Hill, Miss.

description of formations encountered	from	to
White CHALK	0	20
Course SAND	20	29
Little Rock CHALK	29	42
Shell & soft silt	42	77
Grey CHALK	77	84
Fine Silt	84	92
Grey CHALK	92	110
SAND	110	120
Grey CHALK	120	247
Fine SAND	247	287
SAND	287	315

(mailing address)

WELL LOCATION:

sec. 11 T. 15 N R. 4 E
 S W
 0.3 miles SW of Ludlow
 (distance) (direction) (nearest town)

WELL PURPOSE: ~~Hurtig Club~~
(home, irrigation, municipal, industrial)

WELL COMPLETION DATA:

- (1) diameter (inches) 2
- (2) total depth (feet) 315
- (3) static water level (feet) 40 ^{below}/_{above} top of ground.
- (4) casing pc 295
(material) (depth)
2 if telescope see back.
(size)
- (5) screen 20 295
(length) (depth to top)
2" 85/101 pc
(size) (material)
- (6) pump 1 10
(HP) (yield gpm)
etc.
(type power)
- (7) electric log no
(yes or no)

(organization running log)

(8) how well bottom plugged part


DRILLERS REMARKS:

RECEIVED
JAN 3 1978

MISS. BD. OF WATER COMMISSIONERS

If well telescopes please sketch and show depths.

GROUND LEVEL

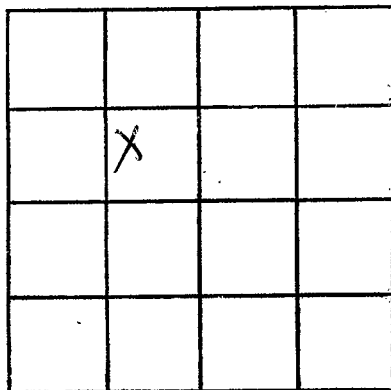

SECTION 11

Please indicate well location X.

ADDITIONAL INFORMATION

If more than one screen, show locations of each on sketch.